

Report Survey and Plat of Co. Road from Ayers on Butte Cr.

Saw mill

 The undersigned Viewers appointed
 at September term of said Court to view out a road commencing
 at or near Thos Ayers on Butte Creek & running from thence
 up said creek & up Spring hollow crossing the ridge to William
 Robinsons thence to the Saw mill after being duly sworn pro-
 ceeded in company with the County Surveyor on the 29th of Sep-
 tember A. D. 1874 to view out survey and otherwise mark off said
 road as the law directs and in accordance with the order of
 said Court and would make the following report That we find
 the same to be a good and practicable route for a road and
 one that is of great utility and would recommend the location
 of the same as a County Road. Butte Creek Oct 2nd 1874

Thomas Scott
 John Shaw

Field notes of Co Road from Ayers to Saw mill

Station	Bearings	Chains	Miles	Remarks	Station	Bearings	Chains	Miles	Remarks
1	N 75 E	24		Commencing at Co road	33	S 57 E	14		
2	N 61 E	16		near Thos Ayers	34	S 40 E	5		
3	S 81 E	17		running from thence	35	S 60 E	4		
4	N 82 E	7		up Butte Creek	36	S 73 E	11		
5	S 81 E	16	1		37	S 108	7	5	
6	S 81 E	2			38	S 74 E	3		
7	N 76 E	7			39	S 40 E	37		
8	S 83 E	5			40	S 22 E	30		
9	N 78 E	5		Antones Ranch	41	S 17 E	10	6	
10	S 72 E	51			42	S 28 N	5		
11	S 81 E	10	2		43	S 24 E	10		
12	S 81 E	20			44	S 68 E	12		
13	S 87 E	22			45	S 57 E	10		
14	N 75 E	12			46	S 85 E	32		
15	S 46 E	6			47	S 79 E	8	7	
16	N 80 E	5			48	S 79 E	4		
17	N 71 E	3			49	N 82 E	8		
18	S 72 E	6			50	East	3		
19	S 60 E	3			51	S 78 E	6		
20	S 28 E	3	3		52	S 74 E	14		
21	S 28 E	2			53	S 67 E	11		
22	N 69 E	11			54	S 60 E	9		
23	S 84 E	12			55	S 86 E	10		
24	S 49 E	20			56	S 63 E	10	8	
25	N 88 E	9			57	S 63 E	23		
26	N 60 E	9		Intersect road to Pilot Rock	58	S 73 E	17		
27	S 62 E	8			59	S 46 E	11		
28	S 70 E	4	4		60	S 73 E	5		
29	S 70 E	16			61	S 76 E	7		
30	S 20 E				62	S 61 E	10		
31	S 60 E	14			63	S 51 E	7	9	
32	S 33 E	5							

Station	Bearings	Chain	miles	Remarks	Station	Bearings	Chain	miles	Remarks
64	S 51 E	5	5		129	S 16 W	8		
65	S 40 E	10			130	S 2 E	2	19	
66	S 60 E	8							
67	S 46 E	9			131	S 2 E	6		
68	S 17 E	9			132	S 12 W	21	386	
69	S 32 E	9		Dr. R. S. Thompson's Ranch	133	S 20 W	30	1980	
70	S 63 E	20	10		134	S 14 W	11	726	
					135	S 18 E	12	20	cross creek in Spring hollow
71	S 60 E	20							
72	S 39 E	9			136	S 18 E	9	594	Road runs up
73	S 47 E	18			137	S 70 E	5	380	Spring hollow
74	S 28 E	9			138	S 28 E	13	858	
75	S 79 E	4			139	S 2 W	13	990	
76	S 27 E	10			140	S 28 W	8	528	
77	N 82 E	0			141	S 2 E	19	1264	
78	S 53 E	0	11		142	S 18 E	11	21	1280
79	S 53 E	19			143	S 9 W	23	1518	
80	S 84 E	10			144	S 21 E	11	726	
81	S 49 E	19			145	S 60 W	22	1452	
82	S 55 E	18		Seaman's farm	146	S 39 E	10	990	
83	S 75 E	3			147	S 21 E	9	22	554
84	S 52 E	9	12						
					148	S 31 E	15	990	Dr. Cowry's farm
85	S 52 E	11			149	S 40 E	10	990	
86	S 5 E	3			150	S 28 E	8	528	
87	S 30 E	56		Wilson's farm	151	S 20 E	11	726	
88	S 11 E	10	13	cross stage road	152	S 21 E	36	23	1376
89	S 68 E	3			153	S 0 W	36	2376	
90	S 34 E	4			154	S 16 W	5	990	
91	S 12 E	2			155	S 4 W	22	1452	
92	S 49 E	6			156	S 9 E	7	24	462
93	S 24 E	3							
94	S 4 E	6			157	S 9 E	16	1056	
95	S 9 E	15			158	S 2 E	29	1914	
96	S 14 E	14			159	S 8 W	10	660	
97	S 9 E	27	14		160	S 7 W	25	25	1650
98	S 11 E	30			161	S 24 W	6	396	
99	S 23 E	18			162	S 17 E	8	528	
100	S 5 E	24			163	S 1 E	9	594	
101	S 13 E	8	15	Dr. eightfoots farm	164	S 24 E	10	990	
					165	S 1 W	7	462	
102	S 55 E	12			166	S 11 W	17	1122	
103	S 2 E	64			167	S 14 W	18	26	1188
104	S 22 W	4	16						
					168	S 22 W	20	1320	
105	S 22 W	14			169	S 31 W	0	830	
106	S 41 W	20			170	S 22 W	10	990	
107	S 43 W	9			171	S 10 W	20	1320	
108	S 27 W	9			172	S 42 W	10	660	
109	S 43 W	6			173	S 39 W	10	77	at the head of Spring hollow 660
110	S 23 W	22	17	J. M. Hamers farm	174	S 39 W	8	528	
					175	S 13 W	48	3888	
111	S 36 W	10			176	S 43 W	16	1056	
112	S 49 W	6			177	S 20 E	5	325	
113	S 83 W	12			178	S 33 E	5	28	330
114	N 60 W	6		cross creek					
115	S 29 W	3			179	S 33 E	20		Dr. Robins's Sheep Ranch 1320
116	S 32 W	6			180	S 8 W	39	2574	
117	S 86 W	3			181	S 41 W	19	1254	
118	S 32 W	10			182	S 25 W	2	132	24 mi
119	S 60 W	17			183	S 30 W	26	1716	
120	S 49 W	7	18	A. Nelson's farm	184	S 37 W	24	1584	
					185	S 65 W	30	30	Dr. pine timber 1980
121	S 49 W	3							
122	S 67 W	5			186	S 65 W	4	924	
123	S 26 W	5			187	S 47 W	12	792	
124	S 47 W	3			188	S 36 W	24	1584	
125	S 66 W	10			189	S 61 W	30	31	1980
126	S 30 W	10							
127	S 67 W	15			190	S 65 W	10	660	
128	S 5 W	4			191	N 75 W	11	726	
					192	N 82 W	39	2574	
					193	N 72 W	20	32	1220

(continued page 77)

Field Notes (continued)


Station	Bearings	Chain	Miles	Remarks
144	N 72° W	5	334	
145	N 83° W	30	1980	
146	S 70° W	31	2076	
147	N 83° W	14	33	494
198	N 83° W	31	2046	
199	S 16° W	9	33 1/2	miles to Saw mill 594.54

Pendleton Oct 6th 1874

I hereby certify that the foregoing is a true copy of the field notes as taken by me of the road from near Thomas Ayers to the Saw mill surveyed September 29th 30th & Oct 1st & 2nd 1874

J. H. Sharon
 Co Surveyor


Plat of Road from Ayers
 to
 Saw mill

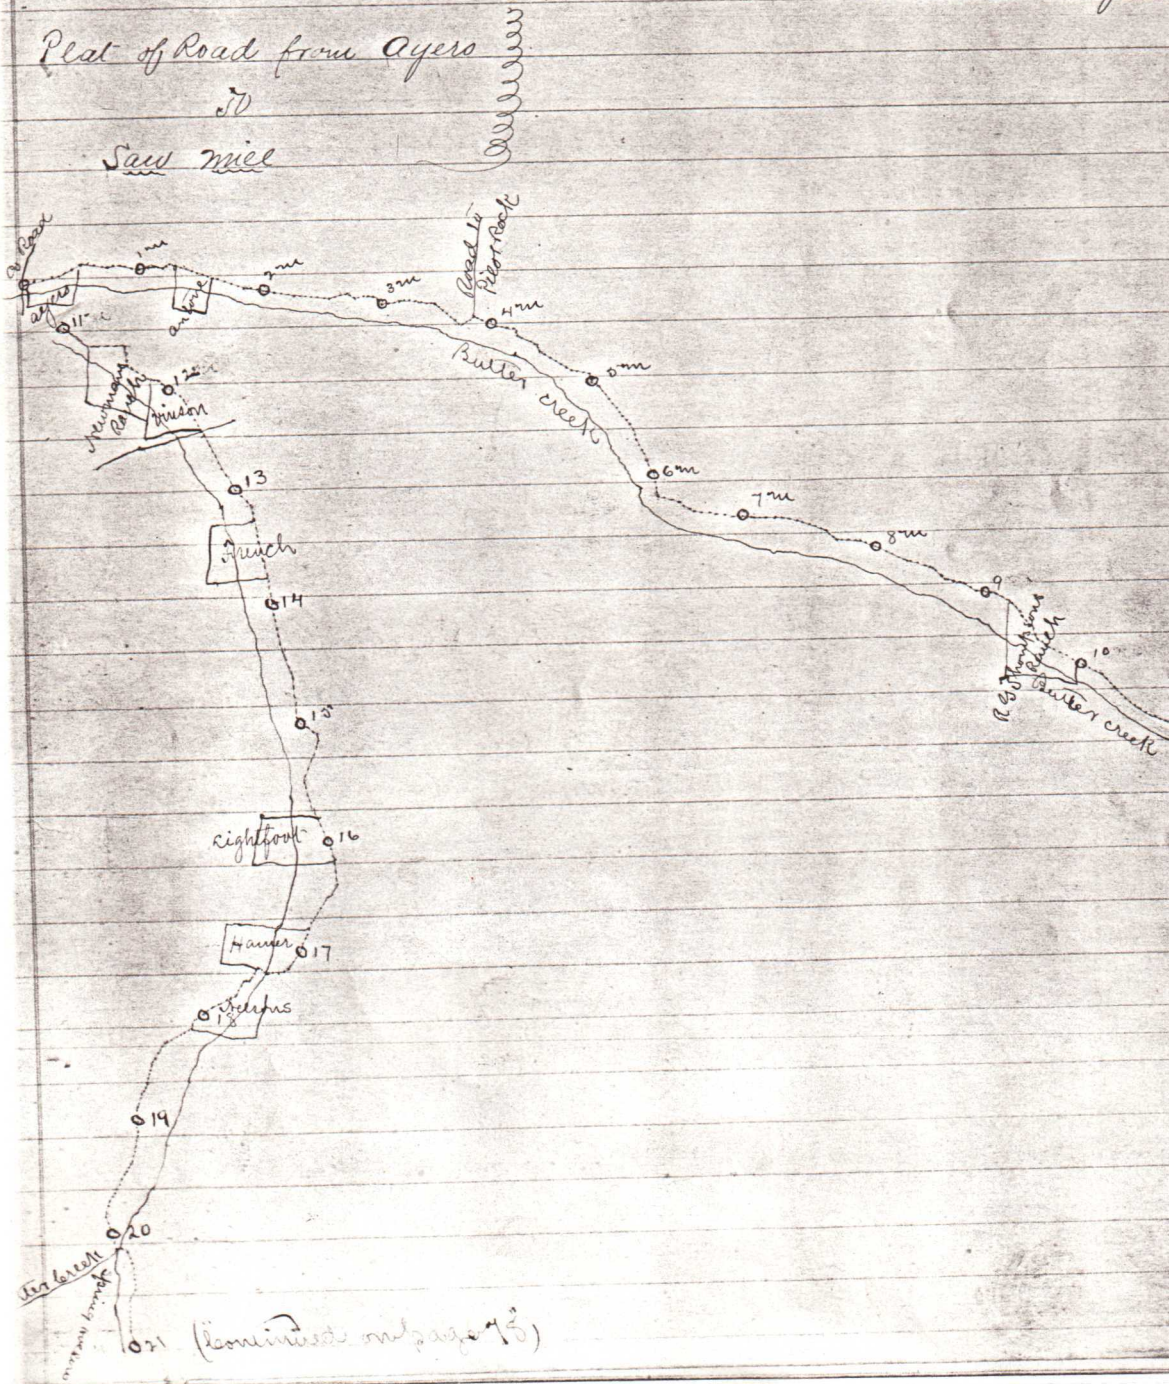

view of road from ayers

Saw mill

(Continued)

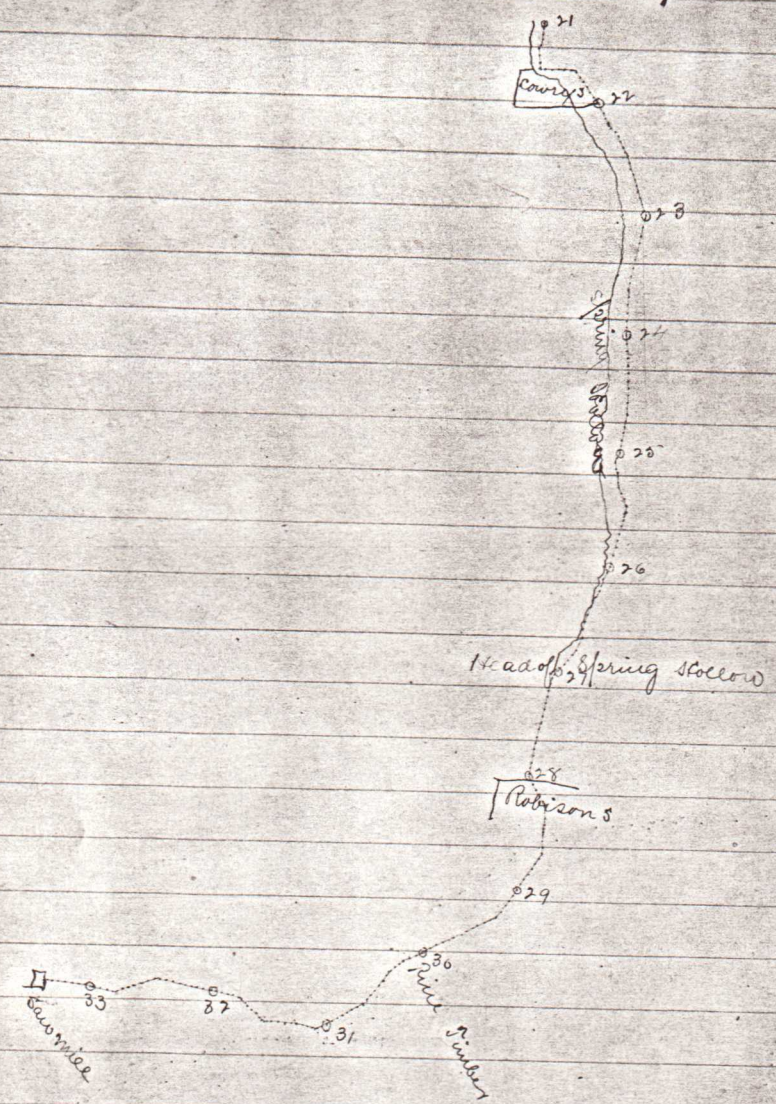

I certify that the above is a correct plat of
 the road as surveyed by me from near
 ayers to the Saw mill Surveyed Sept 29th 30th
 9 Oct 1st 22nd 1874

J. N. Sharon
 Co Surveyor

Road granted and located Jan. 7th 1875
 See Gov. Court Journal "B" page 487