


650

Plat of Road No. 550

In Township No. 4 South of Range 31 East W.M.

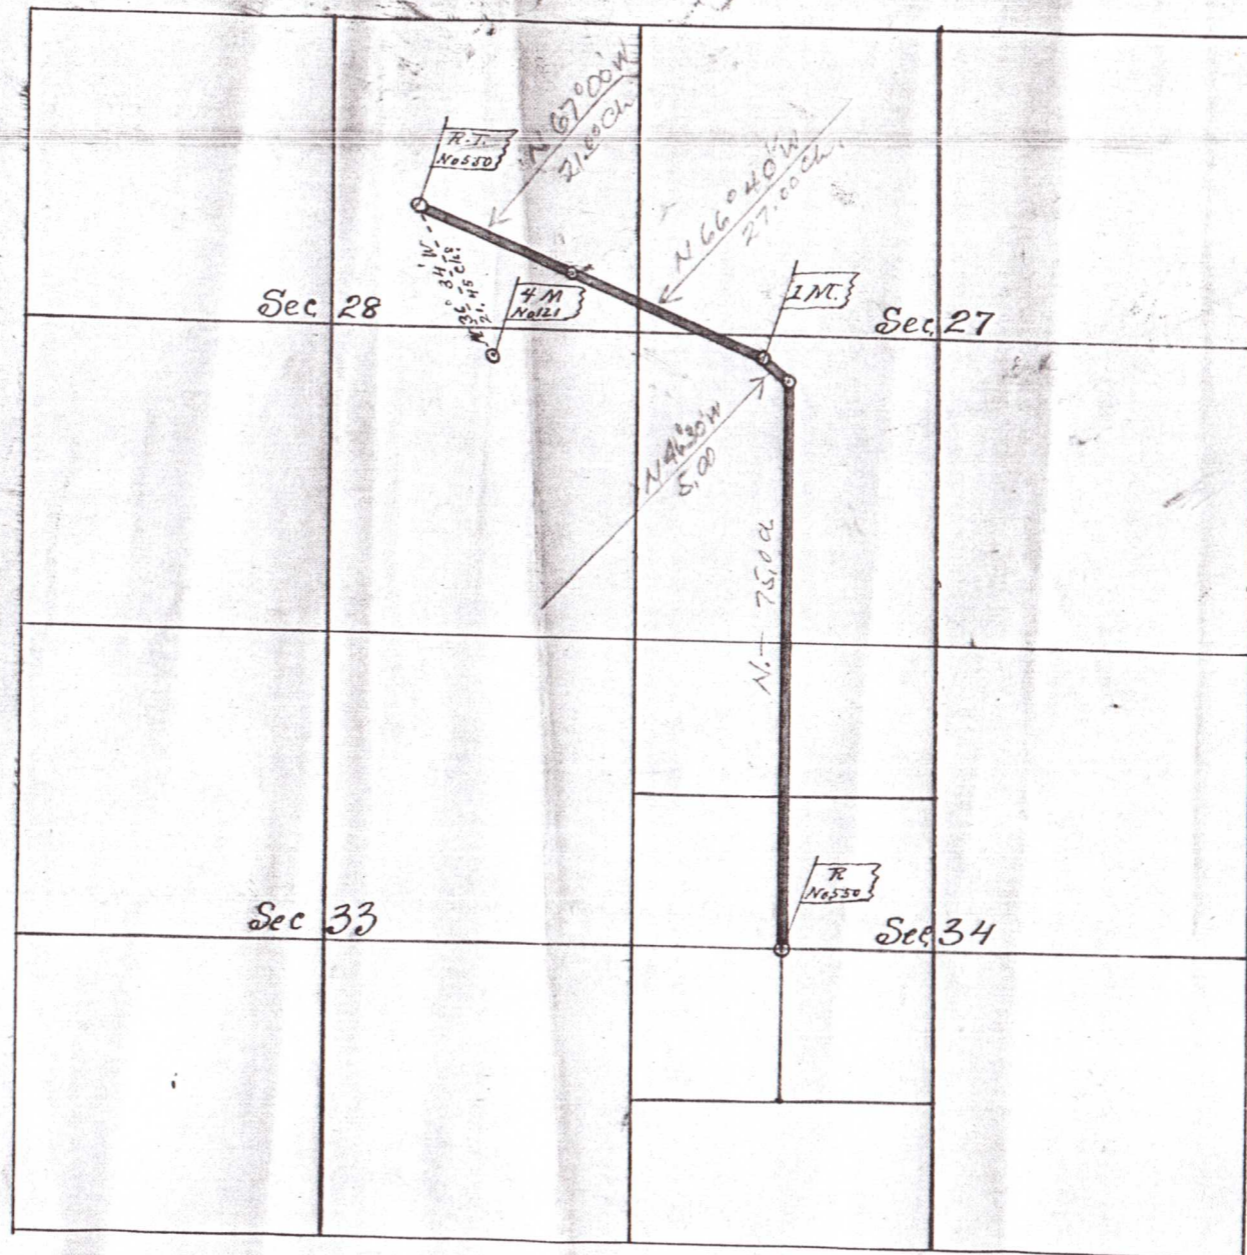

Whereby certifying that the foregoing Plat of Road No. 550 is correct according to survey made by me on the 20th day of June 1903

J. M. Williams
County Surveyor of
Umatilla Co. Oregon