

ROAD NO

301.

Road No 301.

Report of Viewers. Field Notes & Plat of Survey of a County Road running from Hawn & Guyers Sawmill to Little Camas Creek.

Report of Viewers.

To the Honorable County Court for Umatilla County, Oregon.

We the undersigned your viewers appointed to view & report on the advisability of establishing a County road as prayed for by the petition of Edward Bristow & others, viz: Road 301, now ask leave to report that we have carefully examined the route as shown by the accompanying plat & find it practical & we recommend that a county road be located there for reasons following. 1st It is the main road through Camas valley going south. 2nd It is the mail route to Alba, where the Post office, the stores, the church, the saloon, prohibition club, race track & other attractions are located. 3rd The old county road is fenced across & travel obstructed. 4th The location of settlers & character of the surface make a road along this route a necessity for getting into & out of the valley, to town, to the sawmill &c. We would further recommend that the Court order this road opened from Alba to Hawn & Guyers sawmill this fall.

All of which is respectfully submitted.

Dated Alba, Umatilla Co. Oregon Aug 15th 1887.

J. W. Collins }
E. B. Sturdivant } Viewers.
J. Sturdivant }

Field Notes of road survey No 301.

Commencing at a post marked R on the north bank of Little Camas Creek $6\frac{33}{100}$ ^{dths} chains, North 20 degrees West from the South East corner of Section 14-T-5-S-R-31-E-W-M.

	Course	Distance	Angle	Miles	Description
Thence	N 2° W	14.54	A		
"	N 4 W	38.70	A		
"	N 15 W	51.00	A		
"	N 19 W	57.90	A		Across Camas Creek
Bearing tree	E 27 S	.28			Pine 10 inches
Thence	N 20 E	70.07	A		On Section line
"	N	75.59			N E cor Sec 14.
"	N	80.00		1	Set mile post
B'	N 34 E	.23			Pine 16 "
B'	E 20 N	.22			" 12 "
Thence	N	80.00		2	Set mile post
B'	S 12 E	.14			Pine 32 "
"	W 34 S	.65			" 12 "
Thence	N	39.61	A		at quarter post

	Thence	Course	Distance	Angle	Miles	Description
	"	N 9 E	48.21		A	
	"	N 23 W	54.58		A	Pine 36 in'
	"	N	80.00			3 Set mile post across Crown Creek
	"	N 2 W	5.68		A	
	"	N 26 E	9.27		A	
	"	N 22 W	47.71		A	
	"	N 21 E	57.15		A	on section line
	"	N	80.00			4 Set mile post at Connells Creek,
	"	N	80.00			5 Set mile post.
	"	N	8.50		A	
	"	N 20 W	26.77		A	
B'	"	N 42 E	.31			Pine 10 in'
	Thence	N 6 W	39.65		A	
	"	N 21 E	57.22		A	
	"	N 32 E	63.72		A	
	"	E 11 N	79.50		A	
B'	"	S 13 E	.20			" 20 "
	Thence	N	80.00			6 mile post. Pine 6 in'
	"	N	2.23		A	
	"	E 1 S	9.85			To Pine Street. Alba
	"	E 1 S	27.55			" Kenoyer " "
	"	N	30.70			" Wager " "
	"	E	35.18			" Broad " "
	"	N	40.32			To north end of Broad "
	"	N 1 W	47.14		A	
	"	N 8 W	80.00			7 Set mile post
B'	"	E 18 N	.29			Pine 16 "
B'	"	W 42 S	.62			" 14 "
	Thence	N 8 W	8.00		A	
	"	N 32 W	18.20		A	
	"	W 2 N	21.90		A	
	"	W 15 N	28.45		A	
	"	W 2 N	55.92		A	
	"	W 40 N	68.86			
	"	N 36 W	80.00			8 Set mile post
	"	N 36 W	8.00		A	
	"	W 27 N	25.72		A	
	"	W 21 N	31.59		A	
	"	W 35 N	42.41		A	
	"	W 42 N	63.59		A	
	"	N 30 W	74.82			
B'	"	N 30 E	.14			Pine 22 in'

between 104/11-4-31
a point 40 rods from 14 post

oad
report
by
leave to
the
a coun-
road
Alba.
ition
county
ottlers
essity
We
penes
nk of
rom
ion
Creek
es
ne
4.
t
t
post

	Course	Distance	Angle	Miles	Description
B'	" N 15 W	80.00		9	Set mile post
B'	" S 40 E	1.24			Pine 40 in'
"	" N 30 W	.62			" 24 "
Thence	N 15 W	2.65	A		
B'	" W 7 N	.75			Pine 8 "
"	N 32 W	24.22	A		80 rods North of 1/4 post between 10 & 11-4-31
"	W	44.07	A		Pine tree 20 inches
"	W 20 N	50.57	A		
B'	" E 34 N	.51			Pine 8 "
"	N 26 W	60.93	A		
B'	" E	.31			" 12 "
"	N 14 E	68.93	A		
B'	" W 41 S	1.07			" 8 "
"	W 38 N	80.00		10	Set mile post - Rock
B'	" N 8 W	.90			Pine 12 "
B'	" W 12 N	.71			" 18 "
"	W 38 N	.90	A		
B'	" W 34 S	.24			" 12 "
Thence	N 16 W	6.25	A		
B'	" N 10 W	.21			Pine 22 inches
"	W 11 N	14.66	A		
B'	" W 21 N	.30			" 20 "
"	W 1 N	38.41	A		
B'	" S 9 W	.26			" 22 "
"	W 3 N	42.28	A		
B'	" N 42 W	.52			" 12 "
"	W 29 S	50.82	A		
B'	" E 21 S	.30			" 22 "
"	W 2 S	56.50			To Post marked R.
B'	" W 15 S	.31			Alder 6 in.
B'	" W 29 N	1.43			Pine 24" at the bridge over Snake Creek at Hawn & Guyer's Sawmill on Sec 4 T-4-S-R-31-E-W m

I hereby certify that the foregoing are the field notes of road survey N^o 301 as made by myself Aug 3^d 4th & 5th 1887.


La F. Knight
Surveyor

Alba. Umatilla Co Oregon Aug 10th 1887.

Journ
" Road &
Recor

Plat of Road No 301.

Township No 4. South Range 31 E. W. M.

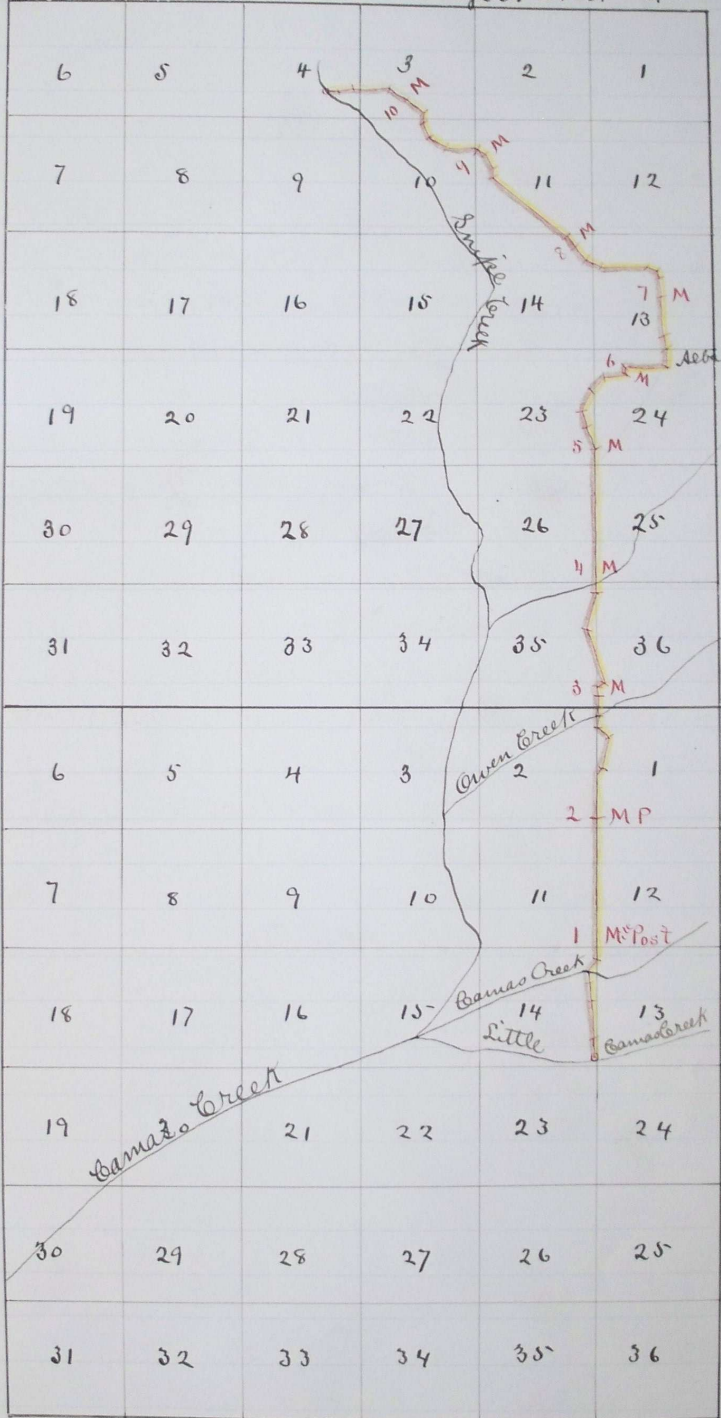

10811-4-31
les

ridge over
on Sec 4

field notes
"4" & "5"

Journal 9. Page 580.

" 9. " 629

Road Granted Sept 26th 1887

Recorded April 17th 1888

G. A. Hartman, Clerk

By J. H. Parkes, Deputy

Alba Oregon August 19th 1887

La F. Knight

Deputy Surveyor