

Filed Nov. 9. 1892 W. M. Pierce County Clerk by J. H. Ripley deputy

ROAD NO 381

In the matter of Viewing Surveying and laying out County Road No 381 commencing at the east end of Well Street in the Town of Ukiah Oregon. Thence easterly By the present traveled Road about one half mile To the old John Day Road. Thence South By Traveled Road about 3/4 mile to the W. B. Bolin Ranch Thence east about 84 rods to E. B. Gambro's Prumption Thence north along said prumption 80 rods thence east by the Present traveled Road 1 + 1/4 miles to the S.E. corner of G. G. Gambro's Homestead Thence East 1/2 mile To stone marked "4 Between Secs 17 + 18 Tp 5 S. R. 32 E. W. M. Thence By most practical route to center of Sec 20 Tp 5 S. R. 32 E. W. M. Thence East one mile Thence South 1/2 mile Thence East 1/2 mile Thence South 1/2 mile Thence South West By the most practical rout to the Present Traveled Road to Little Meadows Thence following said Little Meadows Road to the South line of Sec. 33 Tp 5 S. R. 32 E. W. M. Said Road to be 40 feet wide.

To the Honorable County Court of the State of Oregon for Umatilla County

We the undersigned the Viewers heretofore appointed to view and locate Road No. Submit the following report Pursuant to an order of the Honorable Court we met Jno C. Arnold Surveyor at Ukiah Oregon on the 19th day of June 1892 and was by him each duly sworn to faithfully and impartially discharge the duties of our appointments, we called to our aid J. J. Huston, Arthur Moore Chaimmen Marker who were by the Surveyor each duly sworn. we Viewed surveyed and located said road no 381 as specified in our order.

We find the rout practicable and the road very much needed. We would therefore recommend that road no 381 be declared a public highway.

Witness our respective hands at terminus of road 381 for Umatilla County Oregon this 1st day of July 1892
 James Rippey } Viewers, Road Survey no 381
 Rod Mc Donald }

Filed July 6 - 1892
 W. M. Pierce
 Clerk }

Field Notes of Road Survey No 381 for Umatilla County Oregon

J. West R. McDonald and James Rippey at Ukiah and sworn them in as Viewers on Road Survey No 381 for Umatilla County Oregon - Calling to our aid Suitable assistants of whom Arthur Moore and James J. Huston were sworn as Churn and H.M. Ritter as Marker. Under the direction of said Viewers I proceed to the survey of Road No 381.

I commence at a post, set in a former survey of this road by Sa. J. Knight, Surveyor, which post is a split Laminack $4\frac{1}{2} \times 5 \times 6$ - 2' high marked R on E. and in md of Eeach $1\frac{1}{2}$ ft base by 10 ins high in the center of Well street in the town of Ukiah, Or. and about 300 ft N.W of the Center of Sec 14 T5 S. R. 31 E. - I repair md leaving it $4\frac{1}{2}$ ft base and 2 ft high and cut 381 on West side of Initial post.

From which I run:

Course	Dist	Turn	Remarks
East	8.50	L. 32° 20'	Set Angle Post mkd 1
N. 57° 40' E	33.65	L. 12° 42'	" A. P. mkd 2 in traveled Road
N. 44° 58' E	40.25	R. 72° 06'	" " " 3 at intersection of old Road to Jno Day River
S. 62° 56' E	42.77	R. 43.14	" " " 4 Thence along old Jno Day Wagon Road
S. 19° 42' E	43.00		N. Side of Canvas Creek
	46.13		S. " " " " " "
	49.00		Bridges in two places about 50 lks. below span in winter
	53.53	R. 14° 56'	Dry channel 50 lks wide runs S. W.
S 6.46 E	56.00		Set A. P. mkd 5 on E side of lane
	59.25		Center of dry channel 200 lks wide runs S. W.
	60.26	R. 12° 25'	" " " 30 " " " "
	74.00		Set a. P. mkd 6 on West side of lane
	80.00		Center of swamp 20 lks wide runs west.
	87.75		Set 1 M. P. 45 lks. west of line against fence on West side of lane.
N. 89° 19' E	25.33	L. 90° 06'	Set A. P. mkd 7 leave Jno. Day Road.
N. 0° 37' W	45.40	R. 90° 34'	" " " 8 Cor. of E. B. Gambro's presumption
N. 89° 57' E	65.34		" " " 9 Int. traveled road Course E + W.
	80.00		Cor fence S + W
			Set 2 M. P. post
			June 29 th 1892.
N. 89° 57' E	6.94	R. 61° 14'	Set A. P. mkd 10 at Cor fence W + S
S. 25° 49' E	10.50		Dry channel 50 lks wide runs S. W.
N. 61° 43' E	11.75	L. 69° 28'	" " " 11 at Cor fence N + E on S side of trav R
	14.00	L. 31° 26'	" " " 12 along fence ascending
N. 49° 17' E	17.85	R. 42° 15'	" " " 13 against fence on S. side of trav R
			" " " 13 on Summit N side of trav R

S 55° 26' E	27.50
	80.00
N 89° 13' E	21.70
S. 0° 40' E	30.50
	67.60
	65.75
	75.50
	79.25
	80.00
	2.10
	10.60
	11.50
	13.00
	14.00
	17.50
N 88° 40' E	80.00
N 89° 17' E	7.74
	67.28
S. 0° 47' E	
	80.00
	27.28
N. 89° 09' E	37.25
	2.9

<p>Swan in room H.M. proceed</p>	<p>S. 85° 15' E.</p>	<p>27.50</p>	<p>22' 34"</p>	<p>along traveled road, on N of Genee The 14 Sec. Cor bet Secs. 13+18 S. S. Gambus S.W. Cor.</p>
<p>this marack rch in the Sec 14 ft high</p>	<p>N. 89° 13' E.</p>	<p>27.70</p>	<p>R. 90° 07'</p>	<p>3 M.P. = a basalt stone 30 x 25 x 15 ins. 30 lks. S. of line marked 111 M on N. and 15 on top = made stone md 4 1/2 ft base and 2 ft high around stone A.P. MKd 16 at 14 Sec. Cor. bet. Secs 17+18.</p>
<p>River Road</p>	<p>S. 0° 40' E.</p>	<p>30.50</p>		<p>Descend gently Post Cor. to Secs</p>
<p>runs whole in winter</p>		<p>67.60</p>		<p>channel on S. side of draw 15 lks Wide runs N. W.</p>
<p>S. W.</p>		<p>63.75</p>		<p>Main Summit Foot of Descent - Road N.W + S. E</p>
<p>on</p>		<p>75.50</p>		<p>4 M.P. 30 lks, West of line marked 4 M on N. face Water in ravine 10 lks wide course N. W.</p>
<p>tion W.</p>		<p>79.75</p>		<p>Pine Creek (Dry) 40 lks wide course N. W. Dry channel 10 " " " "</p>
<p>S. W.</p>		<p>80.00</p>		<p>Ascend bluff Summit, Int. E + W line 35 lks. E. of 14 Sec. Cor. bet. Secs. 19 + 20 - set A.P. MKd 17 at Cor.</p>
<p>on</p>	<p>N. 88° 40' E.</p>	<p>80.00</p>	<p>S. 90° 40'</p>	<p>Set 5 M = a stone 30 x 18 x 12 ins marked VM on N face. Set 30 lks. South of line, in open prairie, on gentle South Slope, from which a school (no house to speak of) bears N. E. about 70 chs dist. on south side of Pine Creek</p>
<p>tion W.</p>		<p>77.74</p>	<p>R. 0° 37'</p>	<p>Old A.P. MKd 16 in Stone md = A.P. 17 Stone md 30 dia x 12" high purposing to be center of Sec 21. Rail fence run from this Stone</p>
<p>S. W. of low R</p>	<p>N. 89° 17' E.</p>	<p>67.28</p>		<p>Mound, N-S-E-I set A.P. MKd 18 in this md. along line 70 ft. West of fence, course N. + S. Set 6 M = a basalt stone 22 x 15 x 15 ins. MKd 6 M on on E. set 45 links west of fence purposing to be on center Sec. line, made md of Stone 3 1/2 ft b x 2 ft h. around mile stone digging impracticable</p>
<p>Swan R</p>		<p>80.00</p>		<p>The 14 Sec. Cor. Stone bet Secs 21 + 28. Set A.P. MKd 19 at stone Cor. in mouth of lane Course E.</p>
<p>R</p>	<p>N. 89° 09' E.</p>	<p>27.78</p>	<p>S. 90° 04'</p>	<p>Cor. set by Ra. F. Knight - leave lane - ascend center brush and timber</p>

	45.00		Summit
	52.56		enter field of young grain belonging to Jas Banks
	64.10		beams " " " " " " " "
	69.76		The Cor. to Secs. 21-22 27-28
		R 90° 00	Set a. B. MKD 20 at Sec. cor.
S 0° 51' E			along foot. blazed Sec line
	78.56		Wagon Road bears N 85° W + S 85° E.
	80.00		A tamarack, 30 ins, dia, bears 8 lks. West of line MKD. 7 M R 381 on E.
	17.34		The 14 Sec Cor. bet. Secs. 27 + 28.
			June 31 st or July 1 st - 1892
		R 42° 34'	Set a. B. MKD 21 at 14 Sec. Cor.
S 41° 43' W	38.10	S. 46° 15'	" " " 22 E. of cluster of large pines
S 4° 44' E.	45.97	R. 61° 50'	" " " 23
S 57° 05' W.	50.85	R. 78° 40'	" " " 24
S 87° 45' W.	56.00	S. 40° 06'	" " " 25
S 42° 42' W.	58.00	S. 28° 30'	" " " 26
S 4° 22' W.	67.97	S. 6° 38'	" " " 27
S 2° 16' E.	79.10		A pine 30 ins. dia bears E. of line 11 lks. dist. MKD 8 M R 381 on W. side
	9.34	S. 8° 14'	Set a. B. MKD 28
S 10° 30' E.	13.70	R. 31° 11'	" " " 29
S 20° 42' W.	19.52	R. 18° 06'	" " " 30
S 38° 48' W.	20.81	R. 33° 45'	" " " 31
S 72° 35' W.	26.60	S. 62° 12'	" " " 32
S 10° 21' W.	33.14	S. 5° 10'	" " " 33
S 5° 11' W.	38.80	S. 16° 36'	" " " 34
S 11° 25' E.	48.14	S. 25° 32'	" " " 35
S 36° 57' E.	62.75	S. 4° 45'	" " " 36
	72.77		Cut R 381 on N. side of a leaning scraggy pine 36 ins, dia. on gentle S. slope. on line.

I hereby certify that the foregoing are the correct notes to Survey of Road No 381 for Wasatch County Oregon, and that all the stakes were of legal size & marked & set in mounds as required by law.

Jno. C. Arnold,
Surveyor.

Filed July 13-1892 }
W. M. Pierce }
Clerk }


Plat of Road No 381

Umatilla County Oregon

(Scale 2" = 1 Mile)

Old Survey from Pendleton to John Day River.

Township 5 S. Range 31 E. Township 5 S. Range 32 E. N. M.

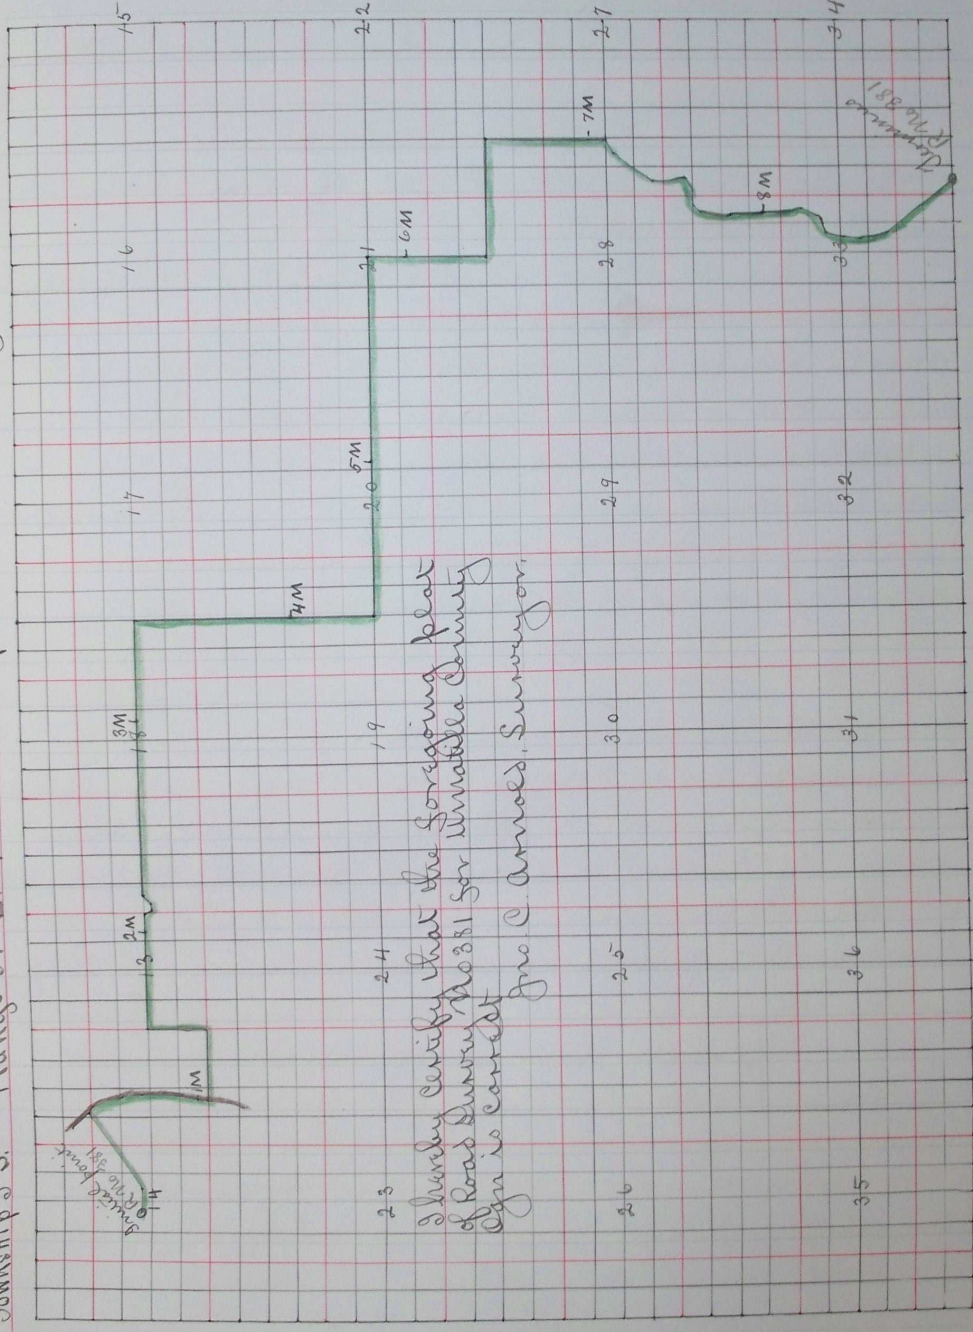

Survey the aw.

Filed July 13-1892
W. M. Pierce
Clerk

J 297