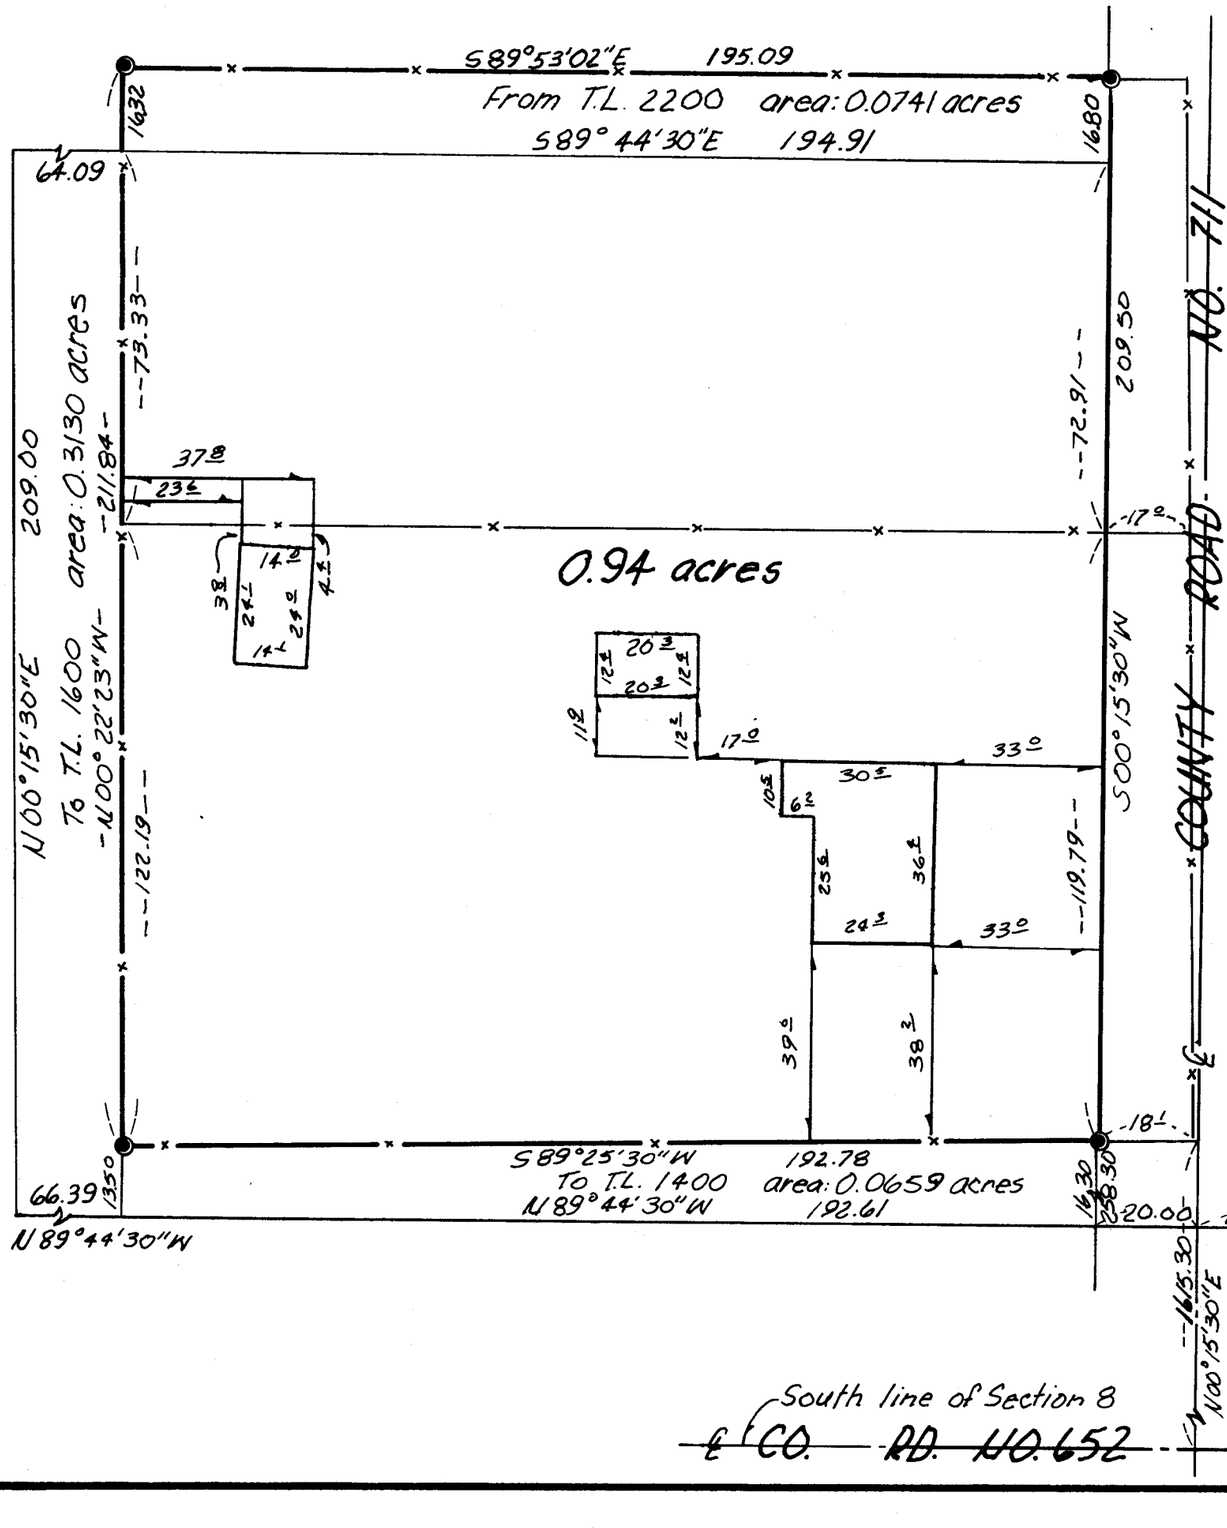


## NARRATIVE

The purpose of this survey was to define the boundaries of a tract of land lying within the fences shown on the drawing.

Bearings were based upon ties to the Plat of "Dickenson Addition" to the County of Umatilla, Oregon.

- ● denotes 5/8 in. x 30 in. iron pin with aluminum cap set
- • denotes 5/8 in. iron pin found
- ○ denotes 1/2 in. iron pin found

RECEIVED BY
Umatilla County Surveyor
Date 6-82
Rec'd By BLS
No. 82-28-A

REGISTERED PROFESSIONAL LAND SURVEYOR
OREGON
JULY 17, 1970
DAVID H. KRUMBEIN
933

Revised January 19, 1982-141

KRUMBEIN ENGINEERING CO
ENGINEERS – SURVEYORS – PLANNERS
221 S Main, Pendleton, Oregon

SCALE 1"=30'
DATE Jan. 6, 1982
DRN BY R.D.R.
CKD BY D.H.K.
DRNG NO. 82-01B

Survey for
PIONEER ESCROW
located in the SE 1/4 of Section 8, T4N, R28E, W.M.

Job No. 81-160 82-28-A