


NARRATIVE

The purpose of this survey was to establish the corners of Lot 12, Block 228. "Reservation Addition" to the City of Pendleton, Umatilla County, Oregon. Points established by Wallulis and Associates under contract to the City of Pendleton were used for controlling points. All angles are right angles as shown on said Plat of "Reservation Addition."

- denotes 3/8 in. x 30 in. iron pin with aluminum cap set
- denotes 2 in. steel pipe end of fence
- denotes monument found as noted

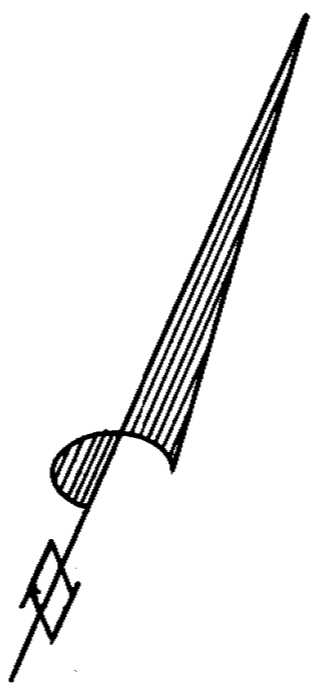

RECEIVED BY
 Umatilla County Surveyor
 Date 11-82
 Rec'd by BLS
 No. 82-129-A

REGISTERED
 PROFESSIONAL
 LAND SURVEYOR
David H. Krumbain
 OREGON
 JULY 17, 1970
 DAVID H. KRUMBEIN
 933

KRUMBEIN ENGINEERING CO.
 ENGINEERS - SURVEYORS - PLANNERS
 221 S. Main, Pendleton, Oregon
 Survey for
MARJORIE E. HAMILTON
 Lot 12, Block 228, "Reservation Addition," Pendleton, Or.

SCALE
 1" = 50'
 DATE
 June 25, 1982
 DRN. BY
 KRH
 CKD BY
 MAI
 DRNG. NO.
 82-19B