


$r = 230.91$
 $A = 136.91$
 $S = 70.53$
 $ch = 134.91$
 $N87^{\circ}04'57''W$

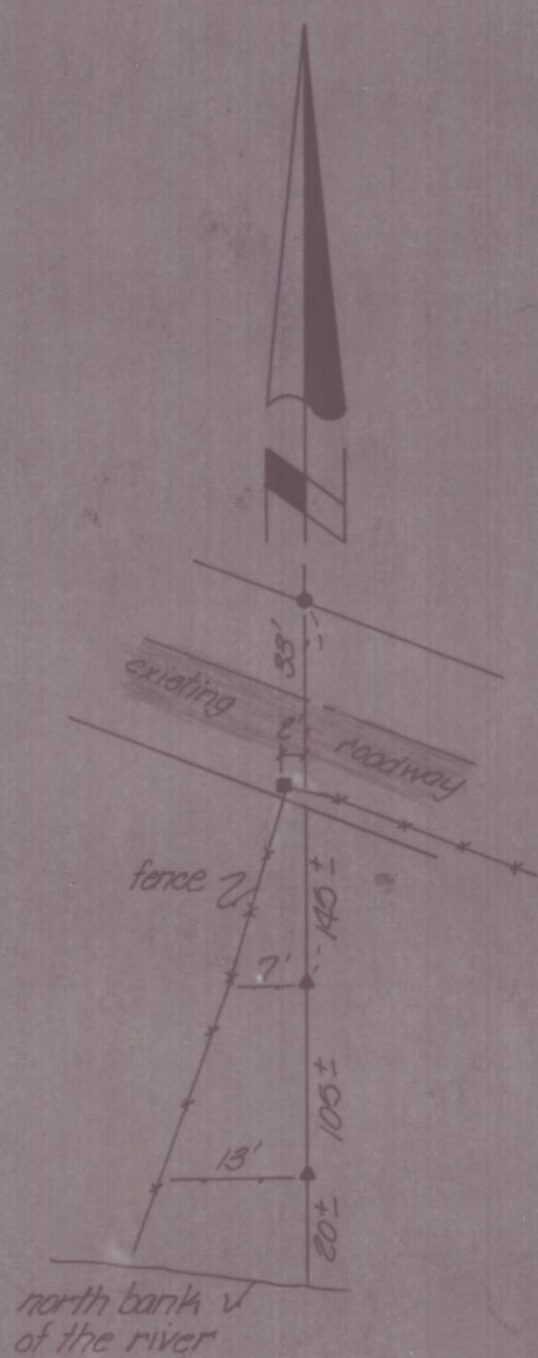

Fence Detail
n.t.s.

NARRATIVE:

The purpose of this survey was to locate the boundaries of that parcel belonging to Mr. Keen as recorded in Book 215, Page 303 of the Umatilla County Deed Records.

Bearings were based on a survey for Klickers by Krumbein Engineering Ltd., Umatilla County Surveyor. Drwg. No. 84-44-C.

Since the only section corner that could be found was the corner common to Sections 18, 17, 19 and 20, the North line of said Keen parcel was established by using the GLO notes and projecting the line East from said section corner the original bearings and distances. The East and West boundaries of said Keen parcel was established from the calls to the dam intersection as described in said Book 215, Page 303.

Pins were set as shown and stakes were set to the South past the creek. The South line of this parcel is on a near vertical hillside.

The East line of said Keen property being 1920 feet West from a line running North-South through the point of intersection of the upper line of the Easterly or upstream face of the main dam with the Southerly face of the Northerly retaining wall of said dam.

- denotes set loth
- denotes found railroad tie fence corner
- denotes set 5/8" x 30" iron pin with aluminum cap stamped PLS 933
- denotes found 5/8" x 30" iron pin with aluminum cap

KRUMBEIN ENGINEERING LTD. ENGINEERS - SURVEYORS - PLANNERS 361 S.E. Second Pendleton, Oregon	Scale 1" = 200'	Drn. By MJD	Drng. No. 84-118	Revision 1 5-16-84
	Date 4-12-84	Ckd. By DHM	Job No. 84-55	Revision 2
Survey for KEEN		REGISTERED PROFESSIONAL LAND SURVEYOR <i>David H. Krumbein</i> OREGON DAVID H. KRUMBEIN 933		RECEIVED BY Umatilla County Surveyor Date 18-84 Rec'd By bc No. 84-111-A

Sec. 22, T6N, R38E, W.M.

84-111-A