


SURVEY FOR THE PORT OF UMATILLA
 IN SE 1/4 Sec. 11, T5N, R28E, W.M.,
 UMATILLA COUNTY, OREGON
 9/8/87 Job # 58709043
 EDWARDS SURVEYING P.O. BOX 763
 567-3336 HERMISTON, OREGON

NARRATIVE: The purpose of this survey is to stake & describe a 10.0 Acre parcel, the west line of which lies 60 feet East of the East line of that Tract described in a lease agreement to Johns-Manville, recorded in B. 325, P. 216, Umatilla Co., Deed Records. The south line of said 10 acre parcel is coincidental with the south line of a 10 Acre tract surveyed in 1982 by Dave Krumbein in a survey for the port of Umatilla. This survey & the bearings are based on said Krumbein's 1982 survey. The road bearing is different from Krumbein's because of a discrepancy in information concerning the road on Krumbein's map.

SCALE: 1" = 100'

- Monuments Found
- 5/8" x 30" Rebar set with Alum tag # 951
- (000) of Record - Krumbein's 1982 Sur for Port of Umatilla
- [000] of Record - Lease Agreement B. 325, P. 216

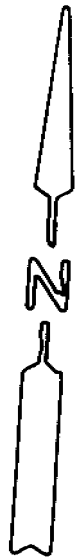

REGISTERED
 PROFESSIONAL
 LAND SURVEYOR

G. Dennis Edwards

OREGON
 JULY 16, 1971
 G. DENNIS EDWARDS
 951

RECEIVED BY
 Date: 11-87
 No. 87-63-A

87-64A