

**NARRATIVE**

The purpose of this survey was to establish those corners shown in Block 256, Reservation Addition.



Control was the intersection of S.E. Isaac with 9th and 10th Streets as shown.

Plot distances and bearings were used. Reference is also made to County Surveyor Drwg. No. G-1119-A for basis of bearing.

- denotes set 5/8" x 30" iron pin with aluminum cap stamped PLS 933
- denotes find PK nail set by the City of Pendleton
- ▽ denotes find R/R Spike set by the City of Pendleton
- denotes find 1/2" iron pin

<b>KRUMBEIN ENGINEERING LTD.</b> ENGINEERS - SURVEYORS - PLANNERS 381 S.E. Second Pendleton, Oregon	Scale 1"=50'	Des. By MLD	Drwg. No. 89068	Revision 1
	Date 8-31-89	Chk. By DHP	Job No. 8937	Revision 2

Survey for  
**ALBERT**  
  
Blk 256, Reservation Addition

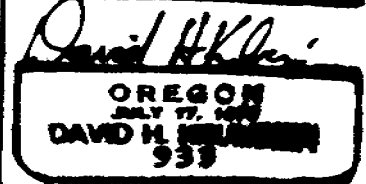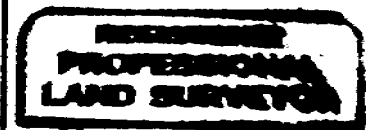

RECEIVED BY  
Umatilla County Surveyor  
Date 8-89  
Rec'd By KA  
No. 89-77-A

89-77-A