


N 0° 57' 34" W  
288.59'  
N 0° 35' 28" E  
1530.79'

Loc. 1/4 Cor  
Computed from  
my Mar. 88 Sur  
for Bonney

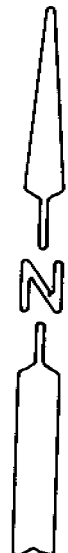

NARRATIVE: The purpose of this Survey is to stake a 4.04 Acre Parcel Bounded on the west by the lands of Christensen & on the NE by the land taken by the U.S. for LAKE WALLULA. I surveyed BONNEY'S WHOLE PARCEL in a March 88 survey. This survey & the bearings are based on that one.

SCALE: 1" = 200'

- MONUMENTS FOUND
- MONUMENTS SET WITH ALUM TAG # 951
- (000) OF RECORD MY MAR. 88 SUR. FOR BONNEY

REGISTERED  
PROFESSIONAL  
LAND SURVEYOR

*G. Dennis Edwards*

OREGON  
JULY 16, 1971  
G. DENNIS EDWARDS  
951

RECEIVED BY  
Umatilla County Surveyor  
Date 10-89  
Rec'd By KA  
No. 89-102-A

SURVEY FOR STUART BONNEY  
IN NW 1/4 Sec 15, T 5N, R 29E, W.M.,  
UMATILLA CO., OREGON  
5/20/89 Job # 58803007-A  
EDWARDS SURVEYING P.O. Box 763  
567-3336 HERMISTON, OR.

89-102-A