NARRATIVE: The purpose of this survey is to stake & describe That portion of Lot 14 lying easterly of a fence line for a lot line adjustment between Lots 1 & 14. I made the northerly line of said parcel the westerly projection of the northerly line of said Lot 1.

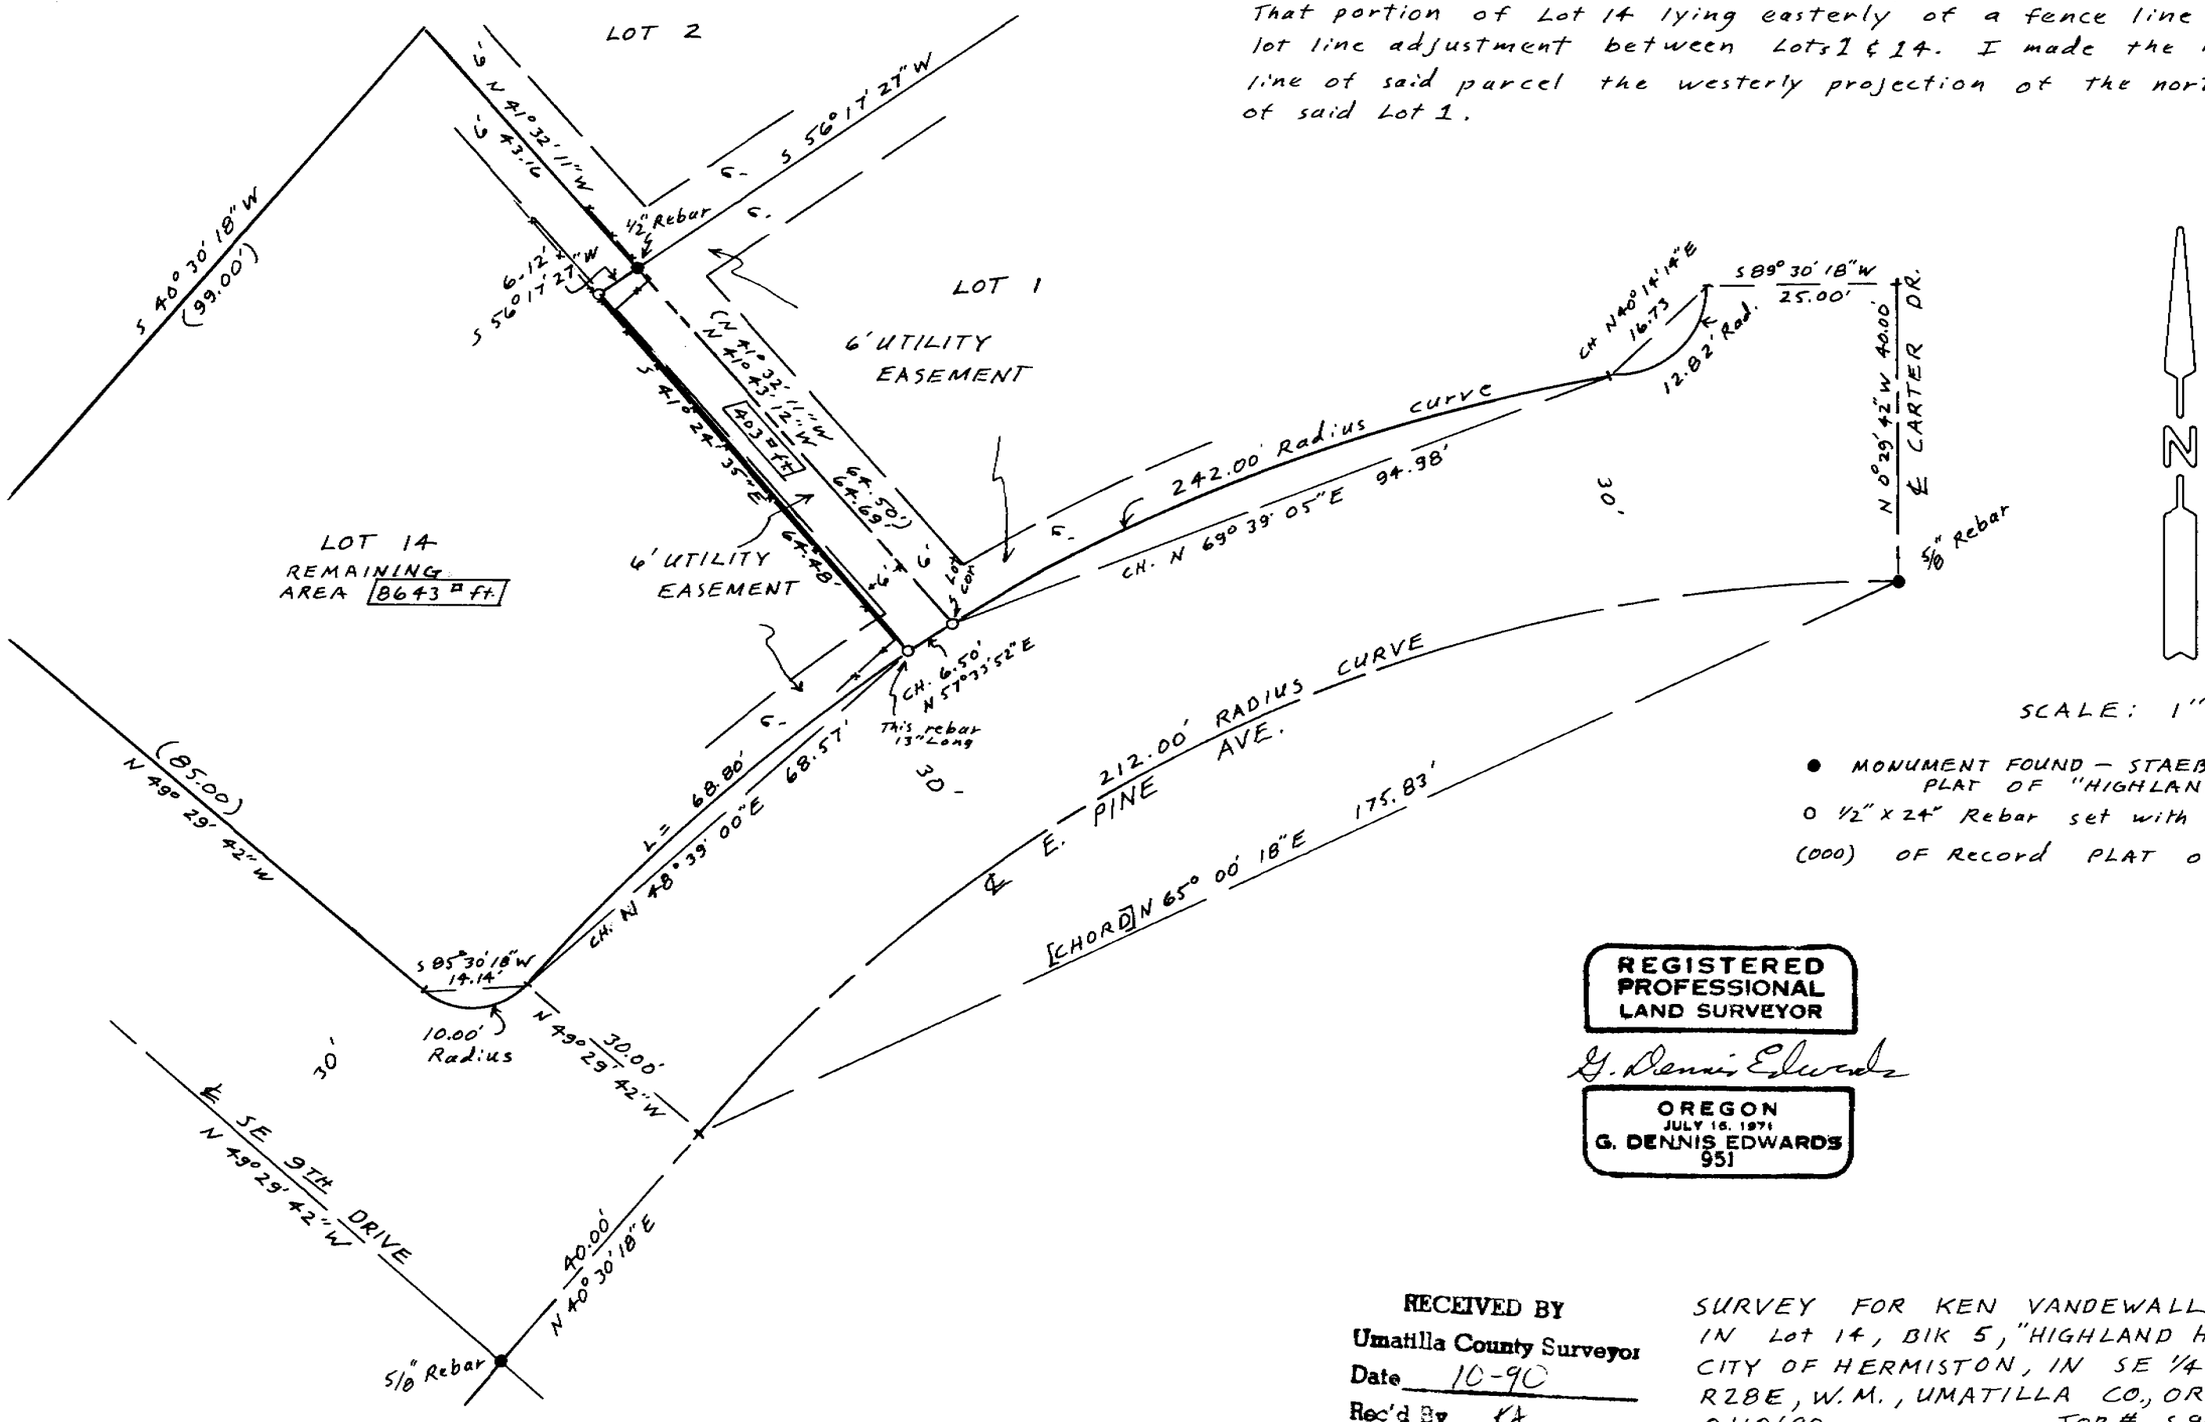

SCALE: 1" = 20'

● MONUMENT FOUND — STAEBLER 1976 for PLAT OF "HIGHLAND HILLS"

o 1/2" x 24" Rebar set with Alum Tag # 951

(000) OF Record PLAT of "HIGHLAND HILLS"

REGISTERED PROFESSIONAL LAND SURVEYOR

G. Dennis Edwards

OREGON
JULY 16, 1971
G. DENNIS EDWARDS
951

RECEIVED BY
Umatilla County Surveyor
Date 10-90
Rec'd By KA
No. 90-69-A

SURVEY FOR KEN VANDEWALL
IN Lot 14, BLK 5, "HIGHLAND HILLS" ADD. TO CITY OF HERMISTON, IN SE 1/4 SEC 11, T4N, R28E, W.M., UMATILLA CO., OREGON.
8/18/90 JOB # S9008049
EDWARDS SURVEYING P.O. BOX 763
567-3336 HERMISTON, OREGON

90-69-A