

NARRATIVE:

The purpose of this survey is to adjust the line between Lots "B" and "C" to accommodate a car port and storage shed on Lot "B"


REGISTERED
PROFESSIONAL
LAND SURVEYOR

G. Dennis Edwards

OREGON
JULY 15, 1981
G. DENNIS EDWARDS
901

LEGEND:

- Found 1/2" rebar. Original Plot, 1976.
- ⊙ Found 5/8" rebar with plastic cap #951. Set by Me, 1992, Replat Blk. 5. Sunland Estates.
- Set 5/8" x 30" rebar with plastic cap #951.

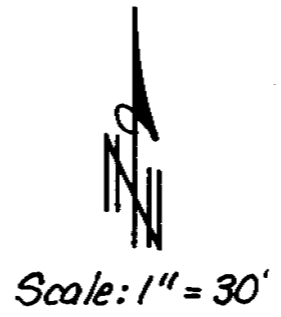

RECEIVED BY
Umatilla County Surveyor
Ltr. 10-94
Rec'd by KK
No. 94-142-A

Survey for **HERMISTON CARE CENTER**
in the "Replat of Block 5, SUNLAND ESTATES"
City of Hermiston, in SE 1/4, NE 1/4 Sec. 16, T4N, R28E,
W.M., Umatilla County, Oregon
8/13/93 ^{REV. 10/21/93} Job # 59204030-C
Edwards Surveying P.O. Box 763
567-3336 Hermiston, Oregon 97838

94-142-A