


NARRATIVE:

The purpose of this survey is to stake the West 180.00 feet of Lot 5, Block 1, "CHARLES TRACTS" so it can be combined with Lot 4, Block 1. I retraced Robinett's 1948 survey of "CHARLES TRACTS" to reset the Northwest corner of Block 1 so I could stake the West 180.00 feet of Lot 5.

REGISTERED PROFESSIONAL LAND SURVEYOR

G. Dennis Edwards

OREGON JULY 16, 1971
G. DENNIS EDWARDS
951
RENEWS 12/31/95

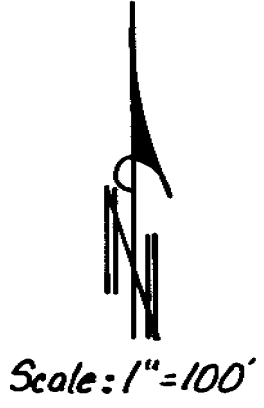

LEGEND:

- Found monuments, Robinett, 1950 Survey, unless noted otherwise.
- Set 5/8" x 30" rebar with plastic cap #951.
- (ooo) of Record. 1948 Plat of "CHARLES TRACTS" by Elmo Robinett.

RECEIVED BY
Umatilla County Surveyor
Date 4-95
Rec'd by KK
No. 95-49-A

Survey for CHARLES KIK
In Lots 4 & 5, Block 1, "CHARLES TRACTS"
In SE 1/4 Section 27, T5N, R28E, W. M.,
Umatilla County, Oregon
2 1 95 Job #59501008
Edwards Surveying P.O. Box 763
503-567-3336 Hermiston, Oregon 97838

95-49-A