

NARRATIVE:

The purpose of this survey is to locate the corners of the south 8 lots of Block 26, "CHARLES TRACTS" so a fence can be built.

I found four lot corners in said Block 26 and used them along with two found in Block 22 and the Southeast corner of Partition Plat #1991-08 to retrace Robinett's 1948 Plat of "CHARLES TRACTS" to set the missing three corners of this parcel.

REGISTERED
PROFESSIONAL
LAND SURVEYOR

G. Dennis Edwards


OREGON
JULY 16, 1971
G. DENNIS EDWARDS
951
RENEWS 12/31/97

LEGEND:

- Found 1/2" Iron Rod set by Robinett in 1948 Plat of "CHARLES TRACTS" unless noted otherwise.
- ⊙ Found bent 1/2" Iron Rod set by Robinett in 1948. Replaced with 5/8" x 30" rebar with plastic cap #951.
- Set 5/8" x 30" rebar with plastic cap #951.
- (ooo) of Record. 1948 Plat of "CHARLES TRACTS" by Elmo Robinett.

RECEIVED BY
Umatilla County Surveyor
Date 5-98
Rec'd By KK
No. 98-85-A

Scale: 1"=100'

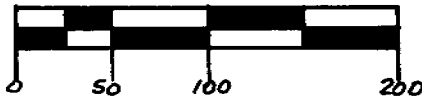

Survey for **STUART BONNEY**
In Block 26, "CHARLES TRACTS"
In the NW 1/4 of Section 27, T5N, R28E, W.M.,
Umatilla County, Oregon
12/18/97 Job #59712288
Edwards Surveying P.O. Box 763
541-567-3336 Hermiston, Oregon 97838

28-85-A