


00-52-A

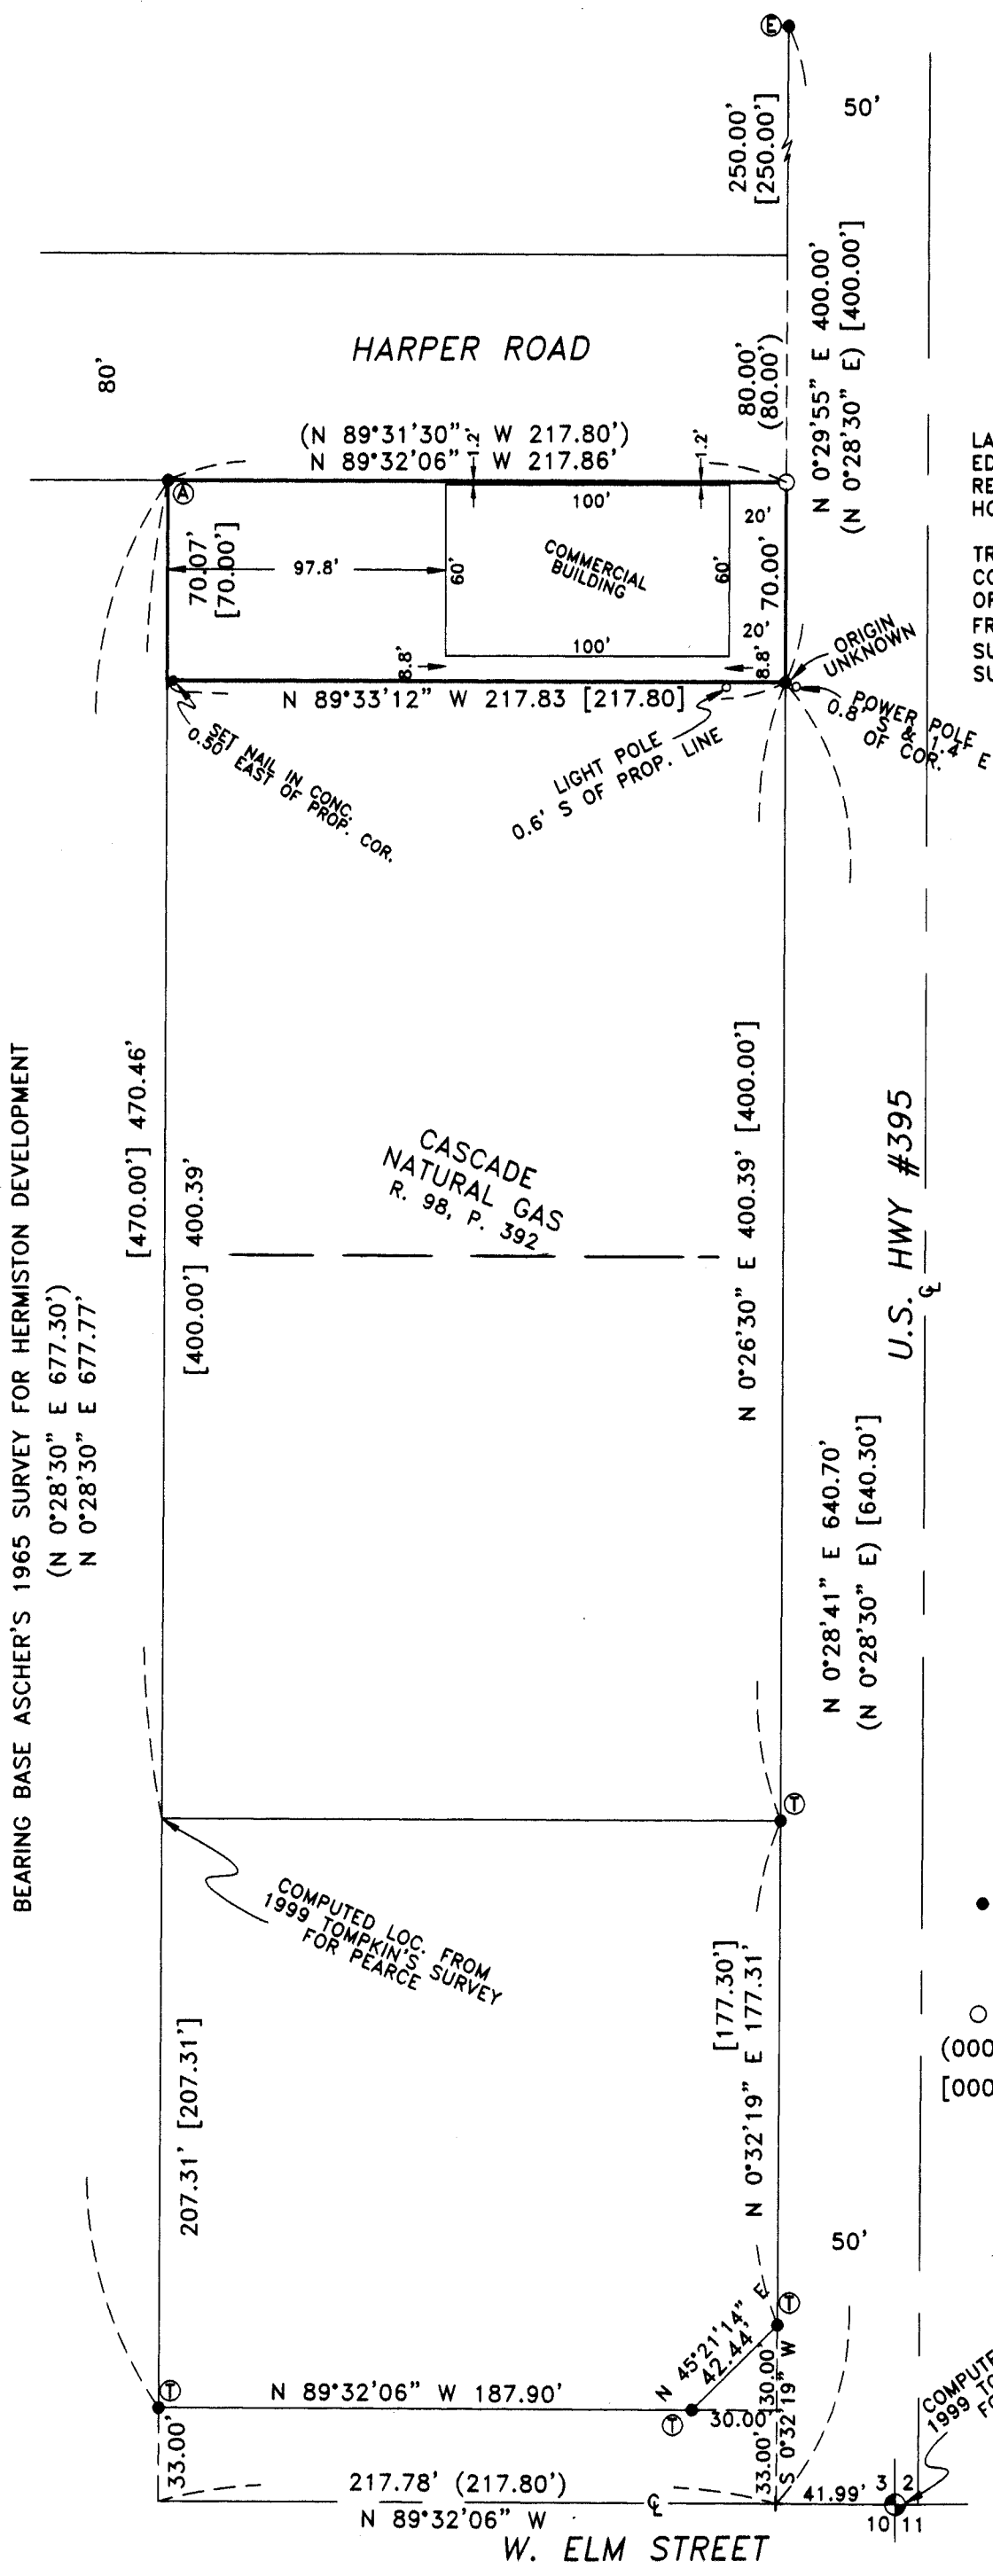

**NARRATIVE:**

THE PURPOSE OF THIS SURVEY IS TO STAKE THAT TRACT OF LAND DESCRIBED AS EXHIBIT "B" IN A DEED TO MARTHA M. EDMISTON REVOCABLE TRUST, DATED JAN. 20, 1998, RECORDED ON REEL 341, PAGE 353, UMATILLA COUNTY DEED RECORDS, TO SEE HOW THE BUILDING LIES IN RELATION TO THE PROPERTY LINES. ASCHER SURVEYED THE NORTH AND WEST LINES OF THIS TRACT IN A 1965 SURVEY FOR HERMISTON DEVELOPMENT CORPORATION. I FOUND HIS MONUMENT AT THE NORTHWEST CORNER OF THIS TRACT, AND RETRACED HIS SURVEY USING MONUMENTS FROM MY 1996 SURVEY FOR ROSS AND FROM TOMKINS' 1999 SURVEY FOR PEARCE WHICH WERE BOTH BASED ON ASCHER'S SURVEY.

REGISTERED  
PROFESSIONAL  
LAND SURVEYOR

*G. Dennis Edwards*

OREGON  
JULY 16, 1971  
G. DENNIS EDWARDS  
9 5 1  
RENEWS 12/31/2001



SCALE: 1"=60'

**LEGEND:**

- FND. 5/8" IRON REBAR
- ⊙ 1965 ASCHER SURVEY FOR HERMISTON DEV.
- ⊙ 1996 EDWARDS SURVEY FOR ROSS
- ⊙ 1999 TOMPKINS SURVEY FOR PEARCE
- SET 5/8"X30" IRON REBAR WITH PLASTIC CAP #951
- (000) OF RECORD 1965 ASCHER SURVEY FOR HERMISTON DEV.
- [000] OF RECORD DEED

SURVEY FOR UMATILLA ELECTRIC CO-OP  
IN SE 1/4, SEC. 3, T 4 N, R 28 E, W.M.,  
UMATILLA COUNTY, OREGON  
2/12/2000 JOB# S0002033  
EDWARDS SURVEYING P.O. BOX 763  
541-567-3336 HERMISTON, OREGON 97838  
DRAWN BY NJF

RECEIVED BY  
Umatilla County Surveyor  
Date 3-2000  
Rec'd By KK  
No. 00-52-A