

NARRATIVE:

THE PURPOSE OF THIS SURVEY IS TO STAKE LOT 1, BLOCK 8, AND LOT 14 BLOCK 9, "UMATILLA HEIGHTS", UMATILLA COUNTY, OREGON, SO TOBRINER AVENUE CAN BE LOCATED.

I RETRACED STORMS 1948 PLAT FROM HIS MONUMENTS THAT I FOUND TO SET THE MISSING CORNERS. MOST OF THE MISSING CORNERS HAD BEEN FARMED OUT AND WERE LYING HORIZONTAL NEAR THEIR ORIGINAL POSITIONS.

REGISTERED
PROFESSIONAL
LAND SURVEYOR


G. Dennis Edwards

OREGON
JULY 16, 1971
G. DENNIS EDWARDS
9 5 1
RENEWS 12/31/2001

SURVEY FOR KIEWIT CONSTRUCTION CO.
IN BLKS. 8 & 9, "UMATILLA HEIGHTS", IN SE 1/4,
SEC. 16, T 5 N, R 28 E, W.M.,
UMATILLA COUNTY, OREGON
5/2/2000 JOB# S0004086
EDWARDS SURVEYING P.O. BOX 763
541-567-3336 HERMISTON, OREGON 97838
DRAWN BY NJF

LEGEND:

- 1/2" SMOOTH I. RODS SET BY STORM'S IN 1948 UNLESS NOTED 5/8"
- SET 5/8"X30" IRON REBAR WITH PLASTIC CAP #951
- ⊙ COMPUTED LOCATION
- (000) OF RECORD STORM'S 1948 PLAT OF "UMATILLA HEIGHTS"

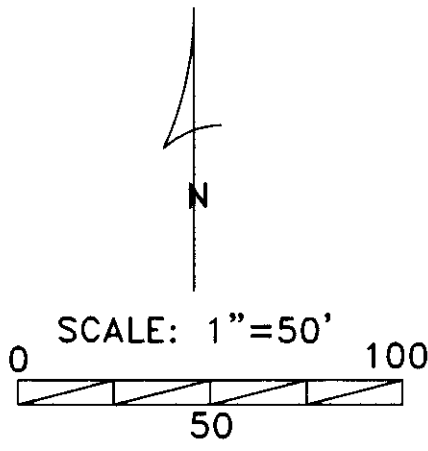

RECORDED BY
Umatilla County Supt
Date 9-00
Rec'd By KK
No. 00-189-A

00-189-A