

**LEGEND:**

- MONUMENTS FOUND AS NOTED
- SET 5/8"X30" IRON REBAR WITH PLASTIC CAP #951
- ⊙ COMPUTED LOCATION

**NARRATIVE:**

THE PURPOSE OF THIS SURVEY IS TO STAKE THE EAST LINE OF THE NW 1/4 OF THE NW 1/4 WHICH IS ALSO THE EAST LINE OF THAT TRACT OF LAND DEEDED TO GOOD SHEPHERD HOSPITAL ON REEL 109, PAGE 361, UMATILLA COUNTY DEED RECORDS.


THE BEARINGS ARE TRUE BASED ON MY MAP #9 OF MY 2004 G.I.S. SURVEY OF HERMISTON FOR UMATILLA COUNTY.

REGISTERED  
PROFESSIONAL  
LAND SURVEYOR

*G. Dennis Edwards*

OREGON  
JULY 16, 1971  
G. DENNIS EDWARDS  
9 5 1

RENEWS 12/31/2005

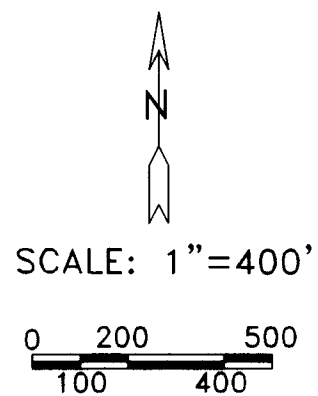

RECEIVED BY

Umatilla County Surveyor

Date 2-05

Rec'd By KK

No. 05-36-A

SURVEY FOR GOOD SHEPHERD HOSPITAL  
IN NW 1/4, NW 1/4, SEC. 10, T 4 N, R 28 E,  
W.M., UMATILLA COUNTY, OREGON  
11/9/04 JOB #P0410209  
EDWARDS SURVEYING P.O. BOX 763  
541-567-3336 HERMISTON, OREGON 97838  
DRAWN BY NJF