

NE COR., L. 1, BLK. 1,  
FND. 5/8" IRON REBAR  
ROBERTS 1997 SURVEY  
FOR MENDOZA

NE COR., L. 1, BLK. 11,  
FND. 1/2" IRON ROD  
HAYS 1954 SURVEY  
FOR ECHO SCHOOLS

**NARRATIVE:**


THE PURPOSE OF THIS SURVEY IS TO STAKE THE CORNERS OF THAT TRACT OF LAND DESCRIBED IN A DEED TO THE ECHO COMMUNITY METHODIST CHURCH IN BOOK 226, PAGE 110, UMATILLA COUNTY DEED RECORDS, (LOT 8 & THE NORTH 1/2 OF LOT 7, BLOCK 5, "KOONTZ 2ND ADDITION" TO THE CITY OF ECHO) SO A FENCE CAN BE BUILT.

I BASED THIS SURVEY & THE BEARINGS ON MY 2004 SURVEY FOR GARCIA IN LOTS 1 & 2, BLOCK 5. SEE THAT SURVEY.

REGISTERED  
PROFESSIONAL  
LAND SURVEYOR

*G. Dennis Edwards*

OREGON  
JULY 16, 1971  
G. DENNIS EDWARDS  
9 5 1  
RENEWS 12/31/2005

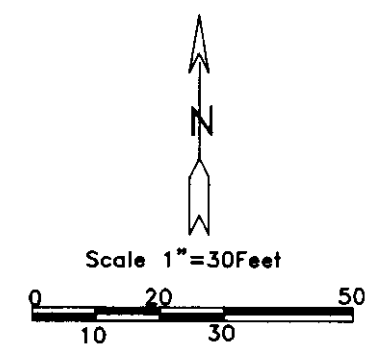

**LEGEND:**

- 5/8" IRON REBAR FOUND, ME 2004 SURVEY FOR GARCIA, UNLESS NOTED OTHERWISE
- SET 5/8"X30" IRON REBAR WITH PLASTIC CAP #951 (000) OF RECORD, PLAT OF "KOONTZ 2ND ADDITION"

SURVEY FOR ECHO METHODIST CHURCH  
IN BLOCK 5, "KOONTZ 2ND ADDITION", CITY  
OF ECHO, IN NE 1/4, SEC. 16, T 3 N,  
R 29 E, W.M., UMATILLA COUNTY, OREGON  
5/10/2005 JOB# S0505080  
EDWARDS SURVEYING P.O. BOX 763  
541-567-3336 HERMISTON, OREGON 97838  
DRAWN BY NJF

RECEIVED BY

Umatilla County Surveyor

Date 7-05

Rec'd by KK

No. 05-140-A

