



NARRATIVE:

THE PURPOSE OF THIS SURVEY IS TO FIND OR SET THE CORNERS OF LOTS 4 & 5 SO A MANUFACTURED HOME AND SHOP CAN BE SITED. I FOUND ALL THE CORNERS THAT STORMS SET IN THE ORIGINAL PLAT OF "HAL BRANDT TRACTS". THE NORTHEAST CORNER OF LOT 5 WAS ABOUT 18 INCHES DEEP & BADLY BENT, SO I SET A NEW MONUMENT NEAR THE SURFACE AT THE CORRECT LOCATION.

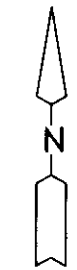

SCALE: 1"=20'

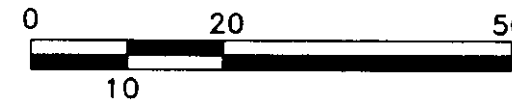

REGISTERED
 PROFESSIONAL
 LAND SURVEYOR

G. Dennis Edwards

OREGON
 JULY 16, 1971
 G. DENNIS EDWARDS
 9 5 1
 RENEWS 12/31/2005

LEGEND:

- FOUND 1/2" IRON ROD, STORMS 1948
- FOUND 5/8" IRON ROD, STORMS 1948
- SET 5/8" X 30" IRON REBAR WITH PLASTIC CAP #951 (000) OF RECORD, 1948 PLAT OF "HAL BRANDT TRACTS"

SURVEY FOR MID COLUMBIA HOMES (JOHNSON)
 IN LOTS 4 & 5, BLK. 2, "HAL BRANDT TRACTS",
 IN SW 1/4, SEC. 2, T 4 N, R 28 E, W.M.,
 UMATILLA COUNTY, OREGON
 5/2/2005 JOB# S0504076
 EDWARDS SURVEYING P.O. BOX 763
 541-567-3336 HERMISTON, OREGON 97838
 DRAWN BY NJF RECEIVED BY

Umatilla County Surveyor
 Date 7-05
 Rec'd by KK
 No. 05-141-A