

Ora T. Hanavan 40A
Bk. 177-P. 271-
Except - 70a.

s.w./4 of N.E./4

1320
 Percy A. Johnson, 430 A.
 BK-162-P.404 s.w./4 of N.E./4

Tatmea - U. 70'

330

Myrtle
 Stevenson

Union Pacific Railroad

U.S. Hwy. 30

s.w./4 : N.E./4

#1183
 Akwityea
 N.E./4 : S.E./4 : N.E./4

70a
 B. 193-
 P. 230
 B-177
 P. 271-

330'

1/4 Corner.

1320

set Iron Pin

Sec. 8 - Assumed as North.

N. 31° 58' E. - 2309 Ft.

N.W./4 : S.E./4

S. 30° 33' W. - 1020'

N.E./4 of S.E./4


S. 15° 02' E. - 1010'

Well and Well House

Well and Well House.

N. 66° 35' E. - 766'

N. 70° 15' E. - 1611 Ft.

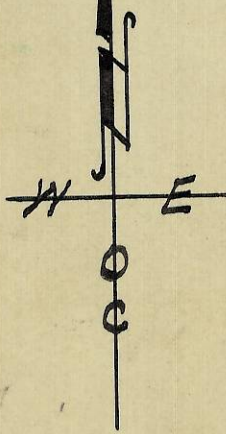

Map showing
 Well Locations in S.E./4 of Sec. 8, T. 2N., R. 33E., W.M.
 owned and operated by
 B. F. Bowman and Richard Purchase
 Surveyed, staked & platted April - 1952.
 Revised & supplemented - Sept. 1952.
 By W. E. O. Criger.
 Scale: 1 in. = 400 Ft.

Application for wells and Umatilla River
 Pump site, and water right by
 Bowman & Purchase.

06-69-A

Ab. 3876 -

89

6