COR
SW¼ & SW¼ Sec. 7

N 21° 29' 20" W 791.20

PLAT OF
BLOCKS 2, 3 & 4
OF THE TOWN OF
DORIS
UMATILLA COUNTY
OREGON
SCALE 1" = 100 FT.

Property Line
N 55° 43' 35" E

NORTH

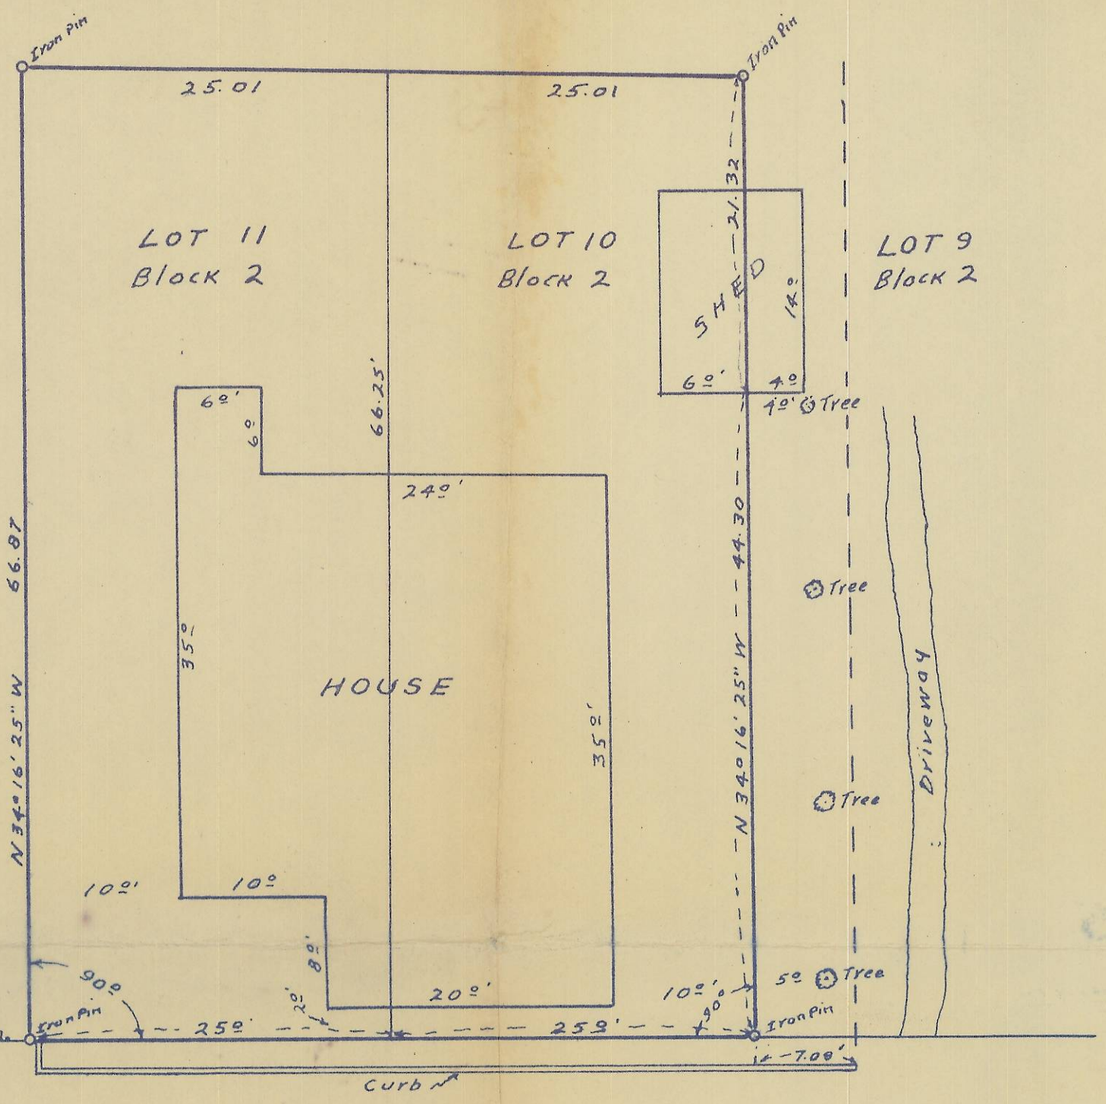

DETAIL PLAT OF LOTS 10 & 11 BLOCK 2
SHOWING LOCATION OF HOUSE, TREES & CURB
SCALE 1" = 10 FT.

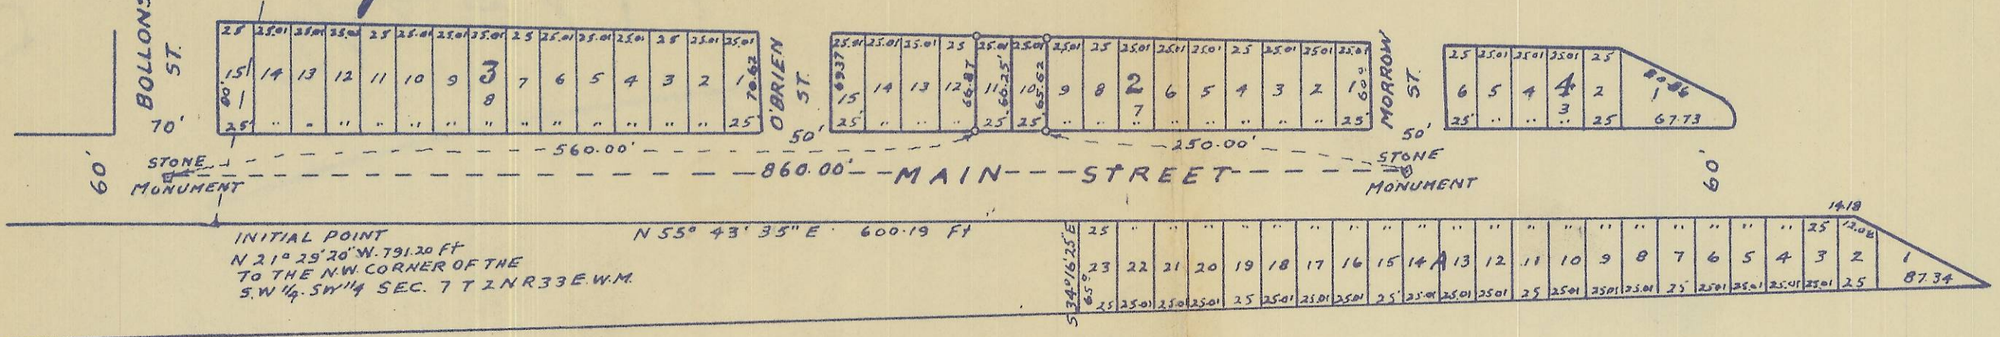

REGISTERED PROFESSIONAL ENGINEER 1497 W. E. O. Criger OREGON MAR 9 1931 W. E. O. CRIGER

Surveyed, staked, and platted,
July + August 1950.
By W. E. O. Criger.
Field work by
H. L. Melton & Jess Yoakum.

2N 33 7CC

06-126-A