

SURVEYOR'S NARRATIVE & CERTIFICATE:


THE PURPOSE OF THIS SURVEY IS TO STAKE THE CORNERS OF LOTS 7, 8, AND 9 BLOCK 1, "HIGHLANDER CENTER UNIT ONE," FOR THE PENDING SALE OF LOT 7. I RETRACED LAGIER'S 1975 "PLAT OF HIGHLANDER CENTER UNIT ONE" TO ESTABLISH THE MISSING MONUMENTS.

RECEIVED BY
 Umatilla County Surveyor
 Date 5-06
 by KF
 No. 06-203-A

REGISTERED PROFESSIONAL LAND SURVEYOR

G. Dennis Edwards

OREGON
 JULY 16, 1971
 G. DENNIS EDWARDS
 9 5 1
 RENEWS 12/31/2007

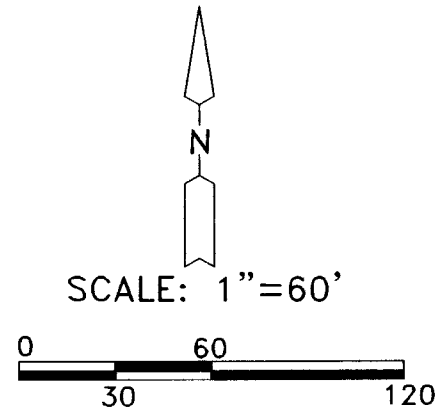

LEGEND:

- FOUND 5/8" IRON REBAR LAGIER 1975 UNLESS OTHERWISE NOTED
- SET 5/8"x30" IRON REBAR WITH PLASTIC CAP #951
- (000) OF RECORD 1975 PLAT IF "HIGHLANDER CENTER UNIT ONE"

SURVEY FOR KEN PETERSON
 LOTS 7, 8, AND 9 OF BLOCK 1, "HIGHLANDER CENTER UNIT ONE," IN NW 1/4 SEC. 24, T 4 N, R 28 E, W.M., UMATILLA CO., OREGON.
 01/26/2006 JOB#S0601008
 EDWARDS SURVEYING P.O. BOX 763
 541-567-3336 HERMISTON, OREGON 97838
 DRAWN BY JMC