DIAGONAL ROAD

122.00°

132°

388

33 33

778.4

165.2

265.5

No. 1

No. 2

No. 3

.98a

.98a

.98a

259.3

346.9

416.9

437.5

58°20'

177°

93.7

118.7

25

25

225°

140°

112°

477°

491°

20 32 10 39.5 36 48.5

S.E.1/4; N.E.1/4; S.E.1/4.

Umatilla County -

578.5

11.3 a. net.

N.E.1/4; S.E.1/4; S.E.1/4

627

660

County Road No. 605

66° Ft. Wide

660' to S.E. Cor. Sec. 1.

553.5

REGISTERED PROFESSIONAL ENGINEER 1497 W. E. O. Criger OREGON MAR. 9, 1931 W. E. O. CRIGER

Plat showing that portion of the S.E.1/4: N.E.1/4: S.E.1/4; and N.E.1/4: S.E.1/4: S.E.1/4; of Sec. 1. T. 4 N., R. 28. E. W. M., Lying south of the Diagonal Road. Also three descriptive tracts located therein. Scale: 1 inch = 100 Feet. Surveyed, staked, and platted, June 1948. By W. E. O. Criger.

Note: West line sec. 1, is 82.85 chains N. & S.
East " " " " 83.45 " " "
Oversize 40's make up North tier sec.

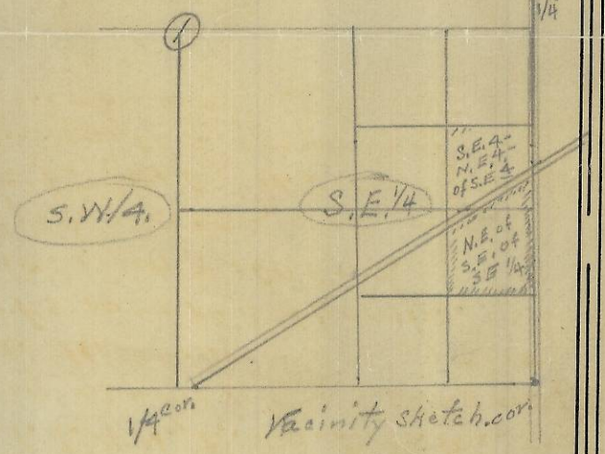

DC-231-A