

NARRATIVE:


THE PURPOSE OF THIS SURVEY IS TO LOCATE THE CORNERS OF LOT 16, BLOCK 2, "NORTH HILL TERRACE" FOR A PENDING SALE.

I RETRACED STAEBLER'S 1979 PLAT OF "NORTH HILL TERRACE" TO SET THE MISSING CORNER. I FOUND A BENT IRON REBAR AT THE NW CORNER, 6" BELOW THE SURFACE, AND REPLACED IT WITH ONE AT THE SURFACE.

REGISTERED
PROFESSIONAL
LAND SURVEYOR

G. Dennis Edwards

OREGON
JULY 16, 1971
G. DENNIS EDWARDS
9 5 1
RENEWS 12/31/2007

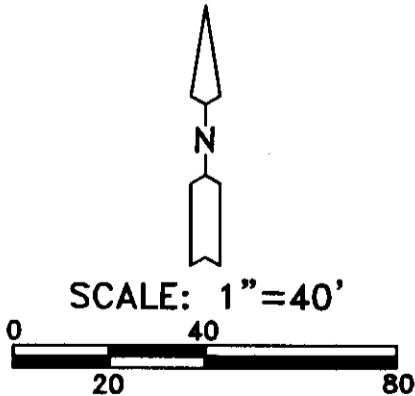

LEGEND:

- FND. STAEBLER'S 1979 MONUMENTS AS NOTED
- SET 5/8" IRON REBAR-PLASTIC CAP 951
- (000) OF RECORD, 1979 PLAT OF "NORTH HILL TERRACE"

SURVEY FOR DONNA CONNER
IN BLK 2 "NORTH HILL TERRACE"
IN SE 1/4, SEC. 33, T 5 N, R 28 E,
W.M., UMATILLA COUNTY, OREGON
07/25/06 JOB #S0607127
EDWARDS SURVEYING P.O. BOX 763
541-567-3336 HERMISTON, OR 97838
DRAWN BY JMC

RECEIVED BY
Umatilla County Surveyor
Date 8-06
Drawn by KR
No. 06-498-A