


**CURVE TABLE:**

#	RADIUS	ARC.	CHORD
C-1	45.00' (45.00')	50.86' (50.91')	N 57°47'19" E 48.20' (N 57°45'30" E 48.24')
C-2	45.00' (45.00')	29.48' (29.47')	N 71°03'52" W 28.96' (N 71°03'20" W 28.95')
C-3	45.00' (45.00')	33.47' (33.47')	N 30°59'07" W 32.71' (N 30°58'30" W 32.71')
C-4	45.00' (45.00')	27.56' (27.48')	N 7°52'19" E 27.13' (N 7°50'20" E 27.06')

**NARRATIVE:**

THE PURPOSE OF THIS SURVEY IS TO STAKE LOTS 3, 4, AND 5, BLOCK 1 "McNARY TOWNSITE DIVISION 2", FOR PENDING SALES. I FOUND THREE ORIGINAL MONUMENTS, AS SHOWN, WHICH FIT THE ORIGINAL PLAT ANGLES AND DISTANCES VERY WELL. I USED THEM TO RETRACE THE ORIGINAL PLAT TO SET THE MISSING CORNERS OF SAID THREE LOTS. I FOUND AND DID NOT USE THREE 1/2" IRON REBARS. ONE VERY BADLY BENT ON THE SOUTH LINE OF LOT 5, A STRAIGHTENED BENT ONE S 82° W 0.5' FROM THE SE COR. OF LOT 5, AND A STRAIGHTENED BENT ONE N 86° W 0.5' FROM THE SW CORNER OF LOT 3. I USED A SOKKIA SET TOTAL STATION TO CONDUCT THIS SURVEY.

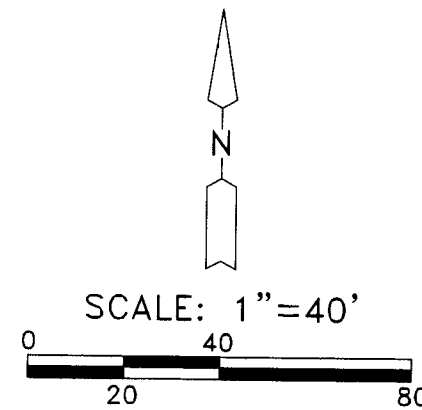

REGISTERED  
PROFESSIONAL  
LAND SURVEYOR  
*G. Dennis Edwards*  
OREGON  
JULY 16, 1971  
G. DENNIS EDWARDS  
9 5 1  
RENEWS 12/31/2015

**RECEIVED BY**  
Umatilla County Surveyor  
Date: 8/27/2015  
Rec'd By: G. Nensley  
No.: 15-076-A

**LEGEND:**

- A ● FOUND 1/2" I. REBAR, HARRIS 1974, PLAT OF "McNARY TOWNSITE DIVISION #2"
  - B ● FOUND 2 1/2" B.C., HARRIS 1974, INITIAL POINT, PLAT OF "McNARY TOWNSITE DIVISION #2"
  - C ● FOUND 1/4" IRON REBAR IN CONC. 2.4' ABOVE SURFACE. THE BASE IS N 30°05' W 0.35' FROM LOT CORNER
    - SET 5/8"X30" IRON REBAR WITH PLASTIC CAP #951
    - ⊙ SET P.K. NAIL
    - Z ⊙ SET P.K. NAIL WITH WASHER STAMPED #951
    - ⊙ COMPUTED LOCATION
- (000) OF RECORD, HARRIS 1974, PLAT OF "McNARY TOWNSITE DIV. #2"

**LINE TABLE:**

L-1	N 25°20'20" E 3.11'
L-2	N 25°20'20" E 48.11' (48.11')
L-3	N 0°10'01" E 45.00'
L-4	N 37°42'15" E 45.00'
L-5	N 80°19'30" E 45.00'
L-6	N 25°20'20" E 45.00' (45.00')
L-7	N 64°35'23" W 15.01' (N 64°39'40" W 15.01')

SURVEY FOR JOHN WAYNE JAMBURA TRUST IN LOTS 3, 4, & 5, BLOCK 1, "McNARY TOWNSITE DIVISION #2," IN THE NE 1/4, NE 1/4, SEC. 15, T 5 N, R 28 E, W.M., UMATILLA COUNTY, OREGON.  
07/29/2015 JOB# S1507054  
EDWARDS SURVEYING P.O. BOX 763  
541-567-3336 HERMISTON, OR 97838  
DRAWN BY JMC