



SEC. 25
SEC. 30
SEC. 36
SEC. 31

NORTH

S 89°55'E. 561'

180'

1320'
S. 89° 5'5' E. 1140'

1/16 Cor. found
hub & tk.

1320' To 1/4 Cor.

SOUTH 1000'

NORTH 607'


N. 89°55' W. 775'

SOUTH 393'

S. 89°55' E. 365'

1320'

SURVEY
FOR
F. C. RYSER
STANFIELD, ORE.
SCALE 1" = 200'

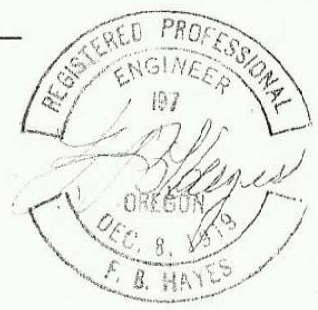

4N-29E

P 11 A