


NOTE:
 North 1/4 Corner of Section 35
 was reset from records of a survey
 made by Guy W. Streamer for
 Elmer Roloff.

- LEGEND:
- Denotes points set during this survey.
 - Denotes points found during this survey.

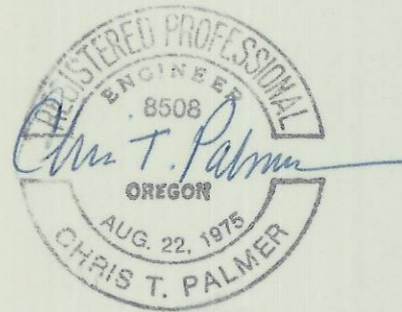

K-45-A

| | | | | |
|---|---------|---|---------|----------|
| Survey for J.L. Fields of a parcel in the N.W. 1/4 of Section 35, T. 6 N., R. 35 E., W.M. | | WAYNE HARRIS CO. INC. ENGINEERS - SURVEYORS PENDLETON, ORE. | | |
| SCALE | DATE | DRN. BY | CKD. BY | DRGN. NO |
| 1"=100' | 2-11-76 | C.T.P. | | 76-372A |

K-45