


VICINITY MAP  
SCALE 1" = 2000'

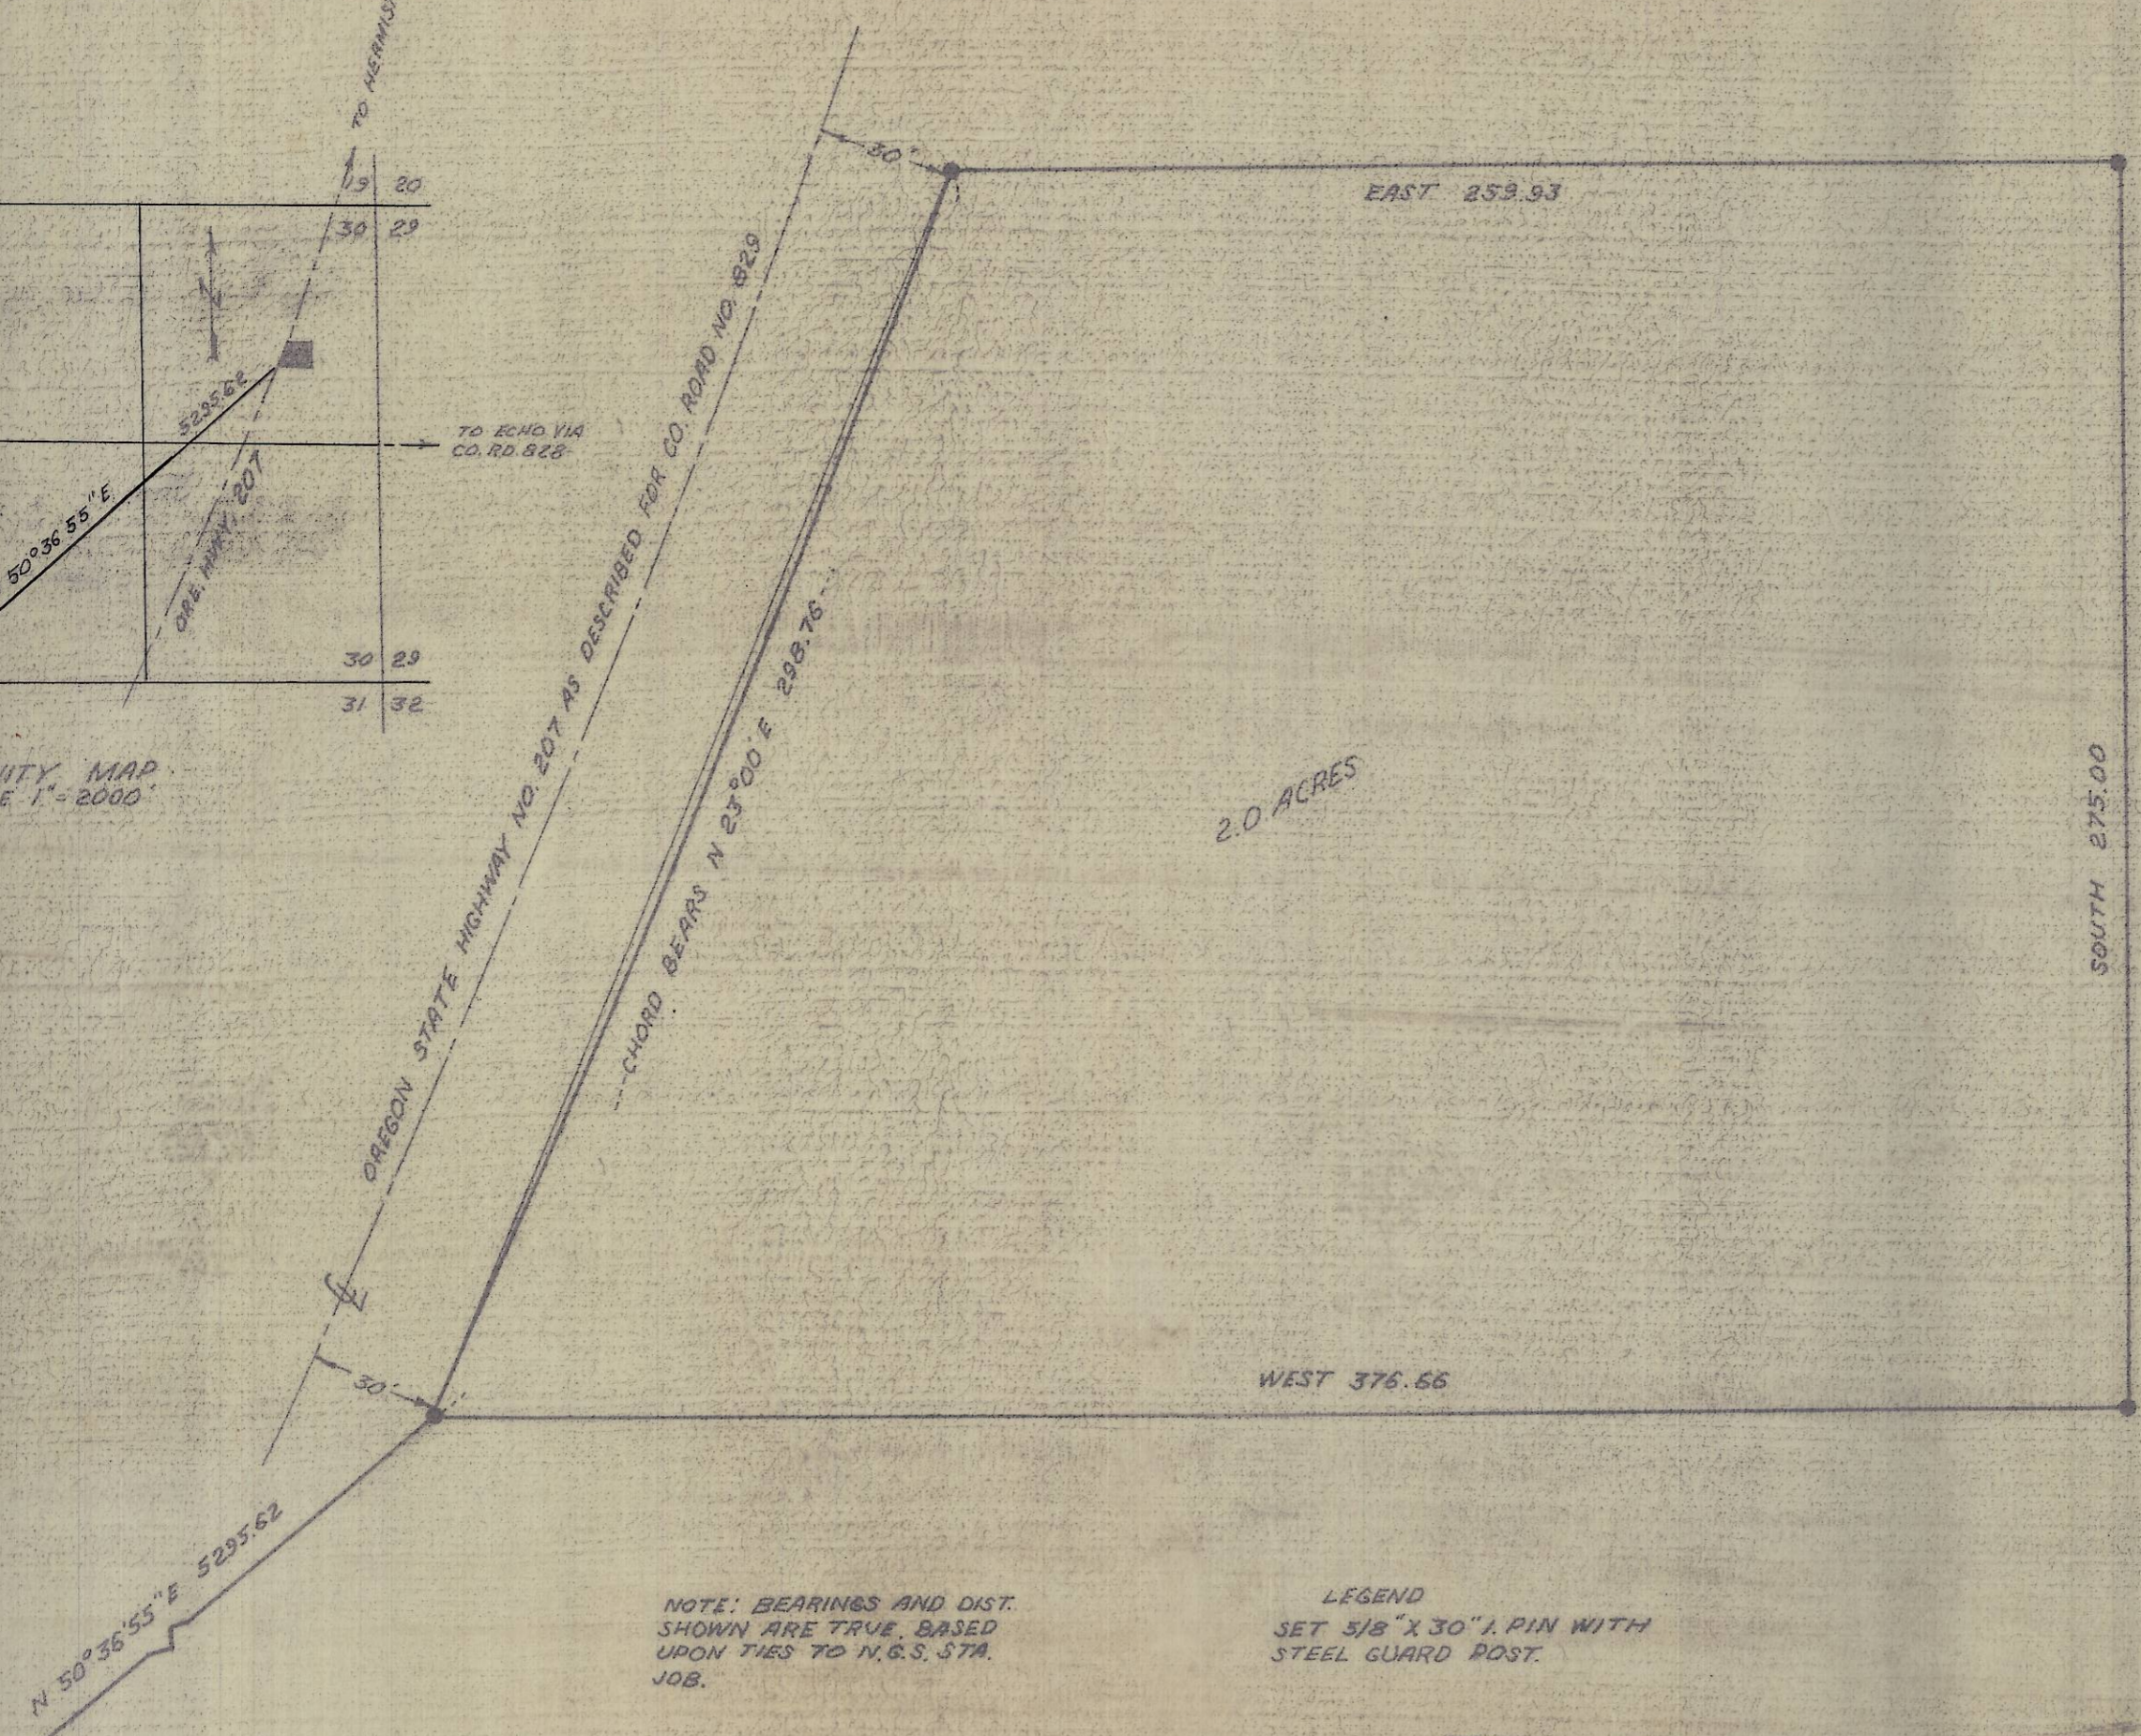

2.0 ACRES

NOTE: BEARINGS AND DIST. SHOWN ARE TRUE, BASED UPON TIES TO N.G.S. STA. JOB.

LEGEND  
SET 5/8" X 30" I. PIN WITH STEEL GUARD POST.



FND. SPIKE AS NOTED ON SURVEY BY STAEBLER, DATED 4/27/72.

T3N R27E T3N R28E

L-36

REGISTERED PROFESSIONAL LAND SURVEYOR  
*David H. Krumbein*  
OREGON  
DAVID H. KRUMBEIN

<b>KRUMBEIN ENGINEERING CO.</b> ENGINEERS - SURVEYORS - PLANNERS 216 S.E. 1st, Pendleton, Oregon	SCALE 1" = 40'
	DATE 13 AUG 76
SURVEY FOR: UMATILLA ELECTRIC COOPERATIVE ASSOCIATION PARCEL IN THE NE 1/4 SECTION 50 T3N, R28E, W.M.	DRAWN BY JLC
	CHECKED BY DHN
	DRAWING NO. 76-408
JOB NO. 76-138	

L-36-A