


Fnd Stone
 $\frac{26}{35} \frac{25}{36}$

Fnd 2" Pipe
 $\frac{25}{36} \frac{30}{31}$

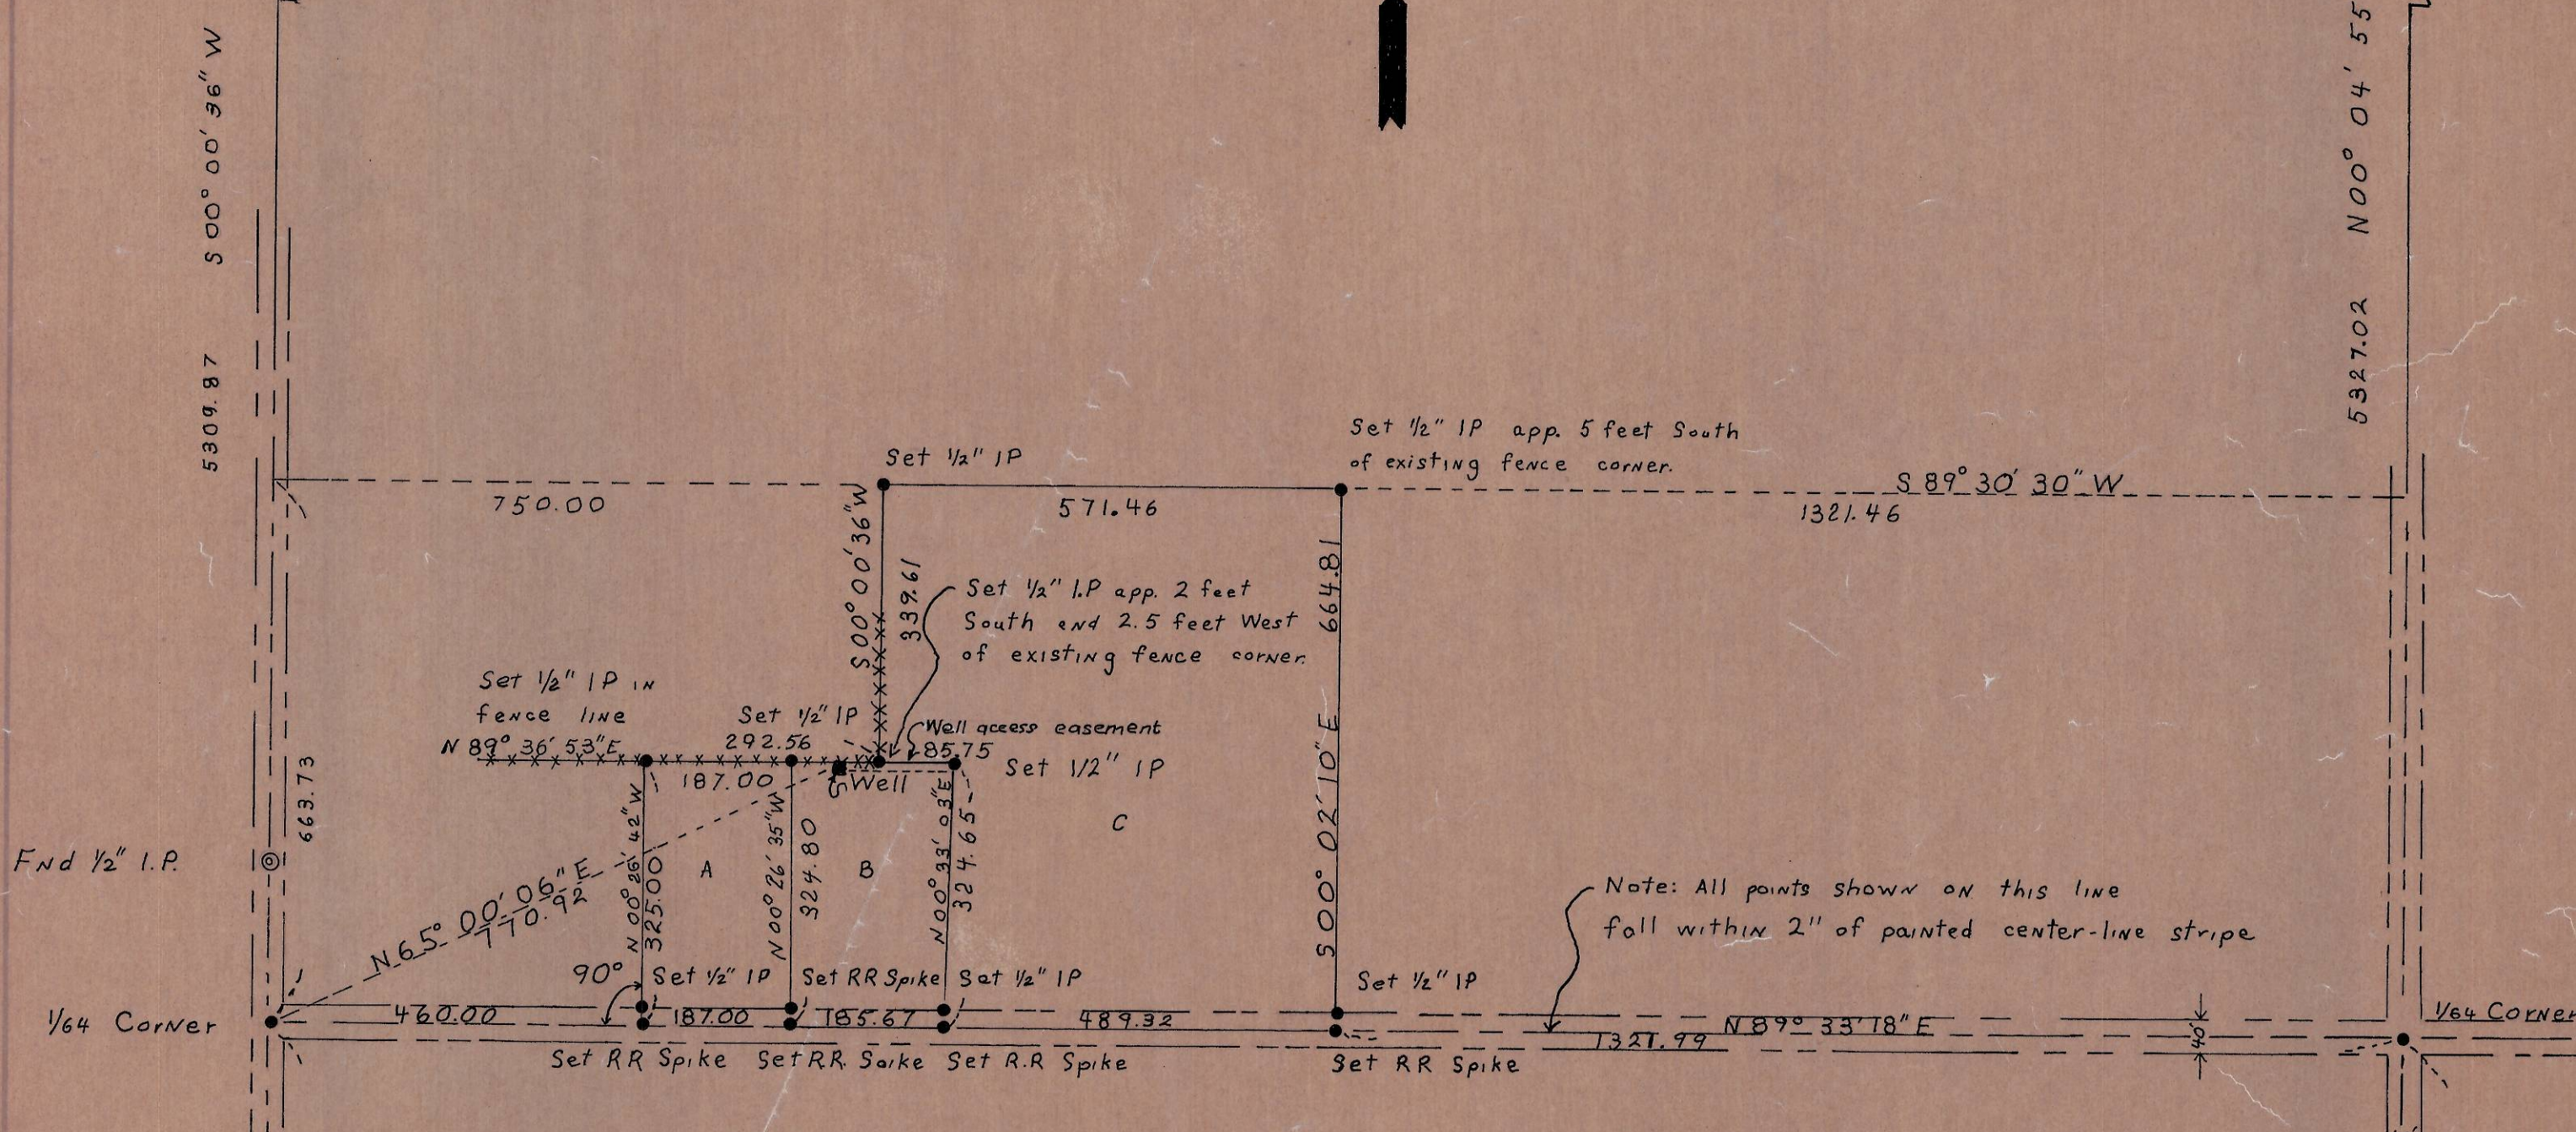

Note: Bearings shown are true bearings and are based on ties to U.S.G.S. triangulation station, Bade, and to previous work done by this company for Kieth Remington.

Legend:
 ● Denotes points set
 ⊙ Denotes points found
 **** Denotes existing fence
 □ Denotes well

Fnd. 3" Pipe
 S 1/4 Cor Sec 36



SURVEY FOR EARL BRUMBACH		WAYNE HARRIS CO. INC.	
PARCEL IN SW 4, SE 4, SEC 36		ENGINEERS SURVEYORS PENDLETON, ORE.	
T6N-R35E	MILTON FREEWATER	SCALE	DATE
UMATILLA COUNTY, OREGON		1" = 200'	10/21/76
		DWN	TW
		CHK	M-38-A
		DWG. NO.	