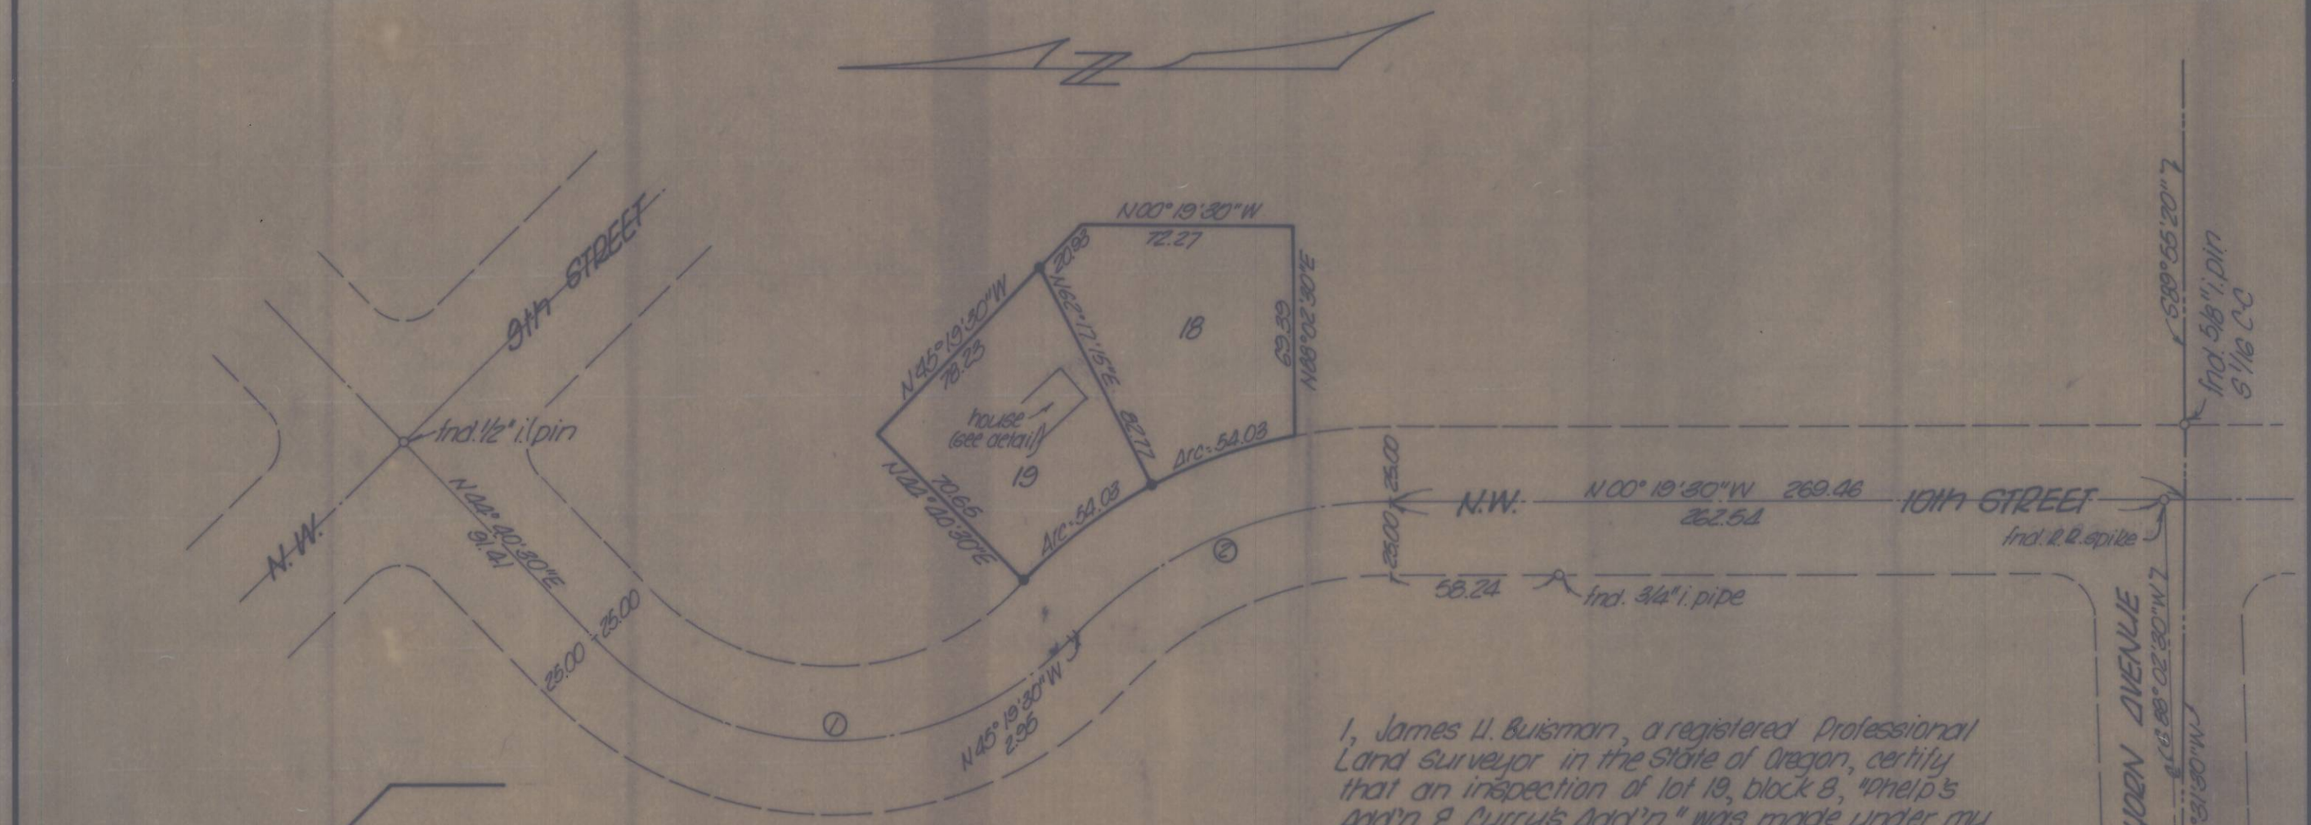

Curve Data

① Δ = 90°00'00"
R = 114.59
L = 180.00
T = 114.59

② Δ = 45°00'00"
R = 150.78
L = 118.42
T = 62.46

Legend:

- ○ denotes found pin
- • denotes 5/8" i. pin set

I, James H. Buisman, a registered Professional Land Surveyor in the State of Oregon, certify that an inspection of lot 19, block 8, "Phelp's Add'n. & Curry's Add'n." was made under my direction on March 17, 1978, that said parcel was identified by the monuments and improvements shown, the building on said parcel does not encroach upon the adjoining property and that the buildings upon the adjoining properties do not encroach upon said parcel.

James H. Buisman
James H. Buisman, P.L.S. #1097
dated this 17th day of March, 1978.

REGISTERED PROFESSIONAL LAND SURVEYOR
James H Buisman
OREGON JULY 22, 1977 JAMES H. BUISMAN 1097

KRUMBEIN ENGINEERING CO.
ENGINEERS – SURVEYORS – PLANNERS
221 S. Main, Pendleton, Oregon

Survey for
MIKE MYRICK
lots 18 & 19, blk. 8, "Phelp's & Curry's Add'n."

SCALE 1"=60'
DATE Mar. 17, 1978
DRN. BY P.L.S.
CKD. BY T.E.U.
DRNG. NO. 78-12 B

O-46

A

O-46-A Job No. 78-64