


O-83-A

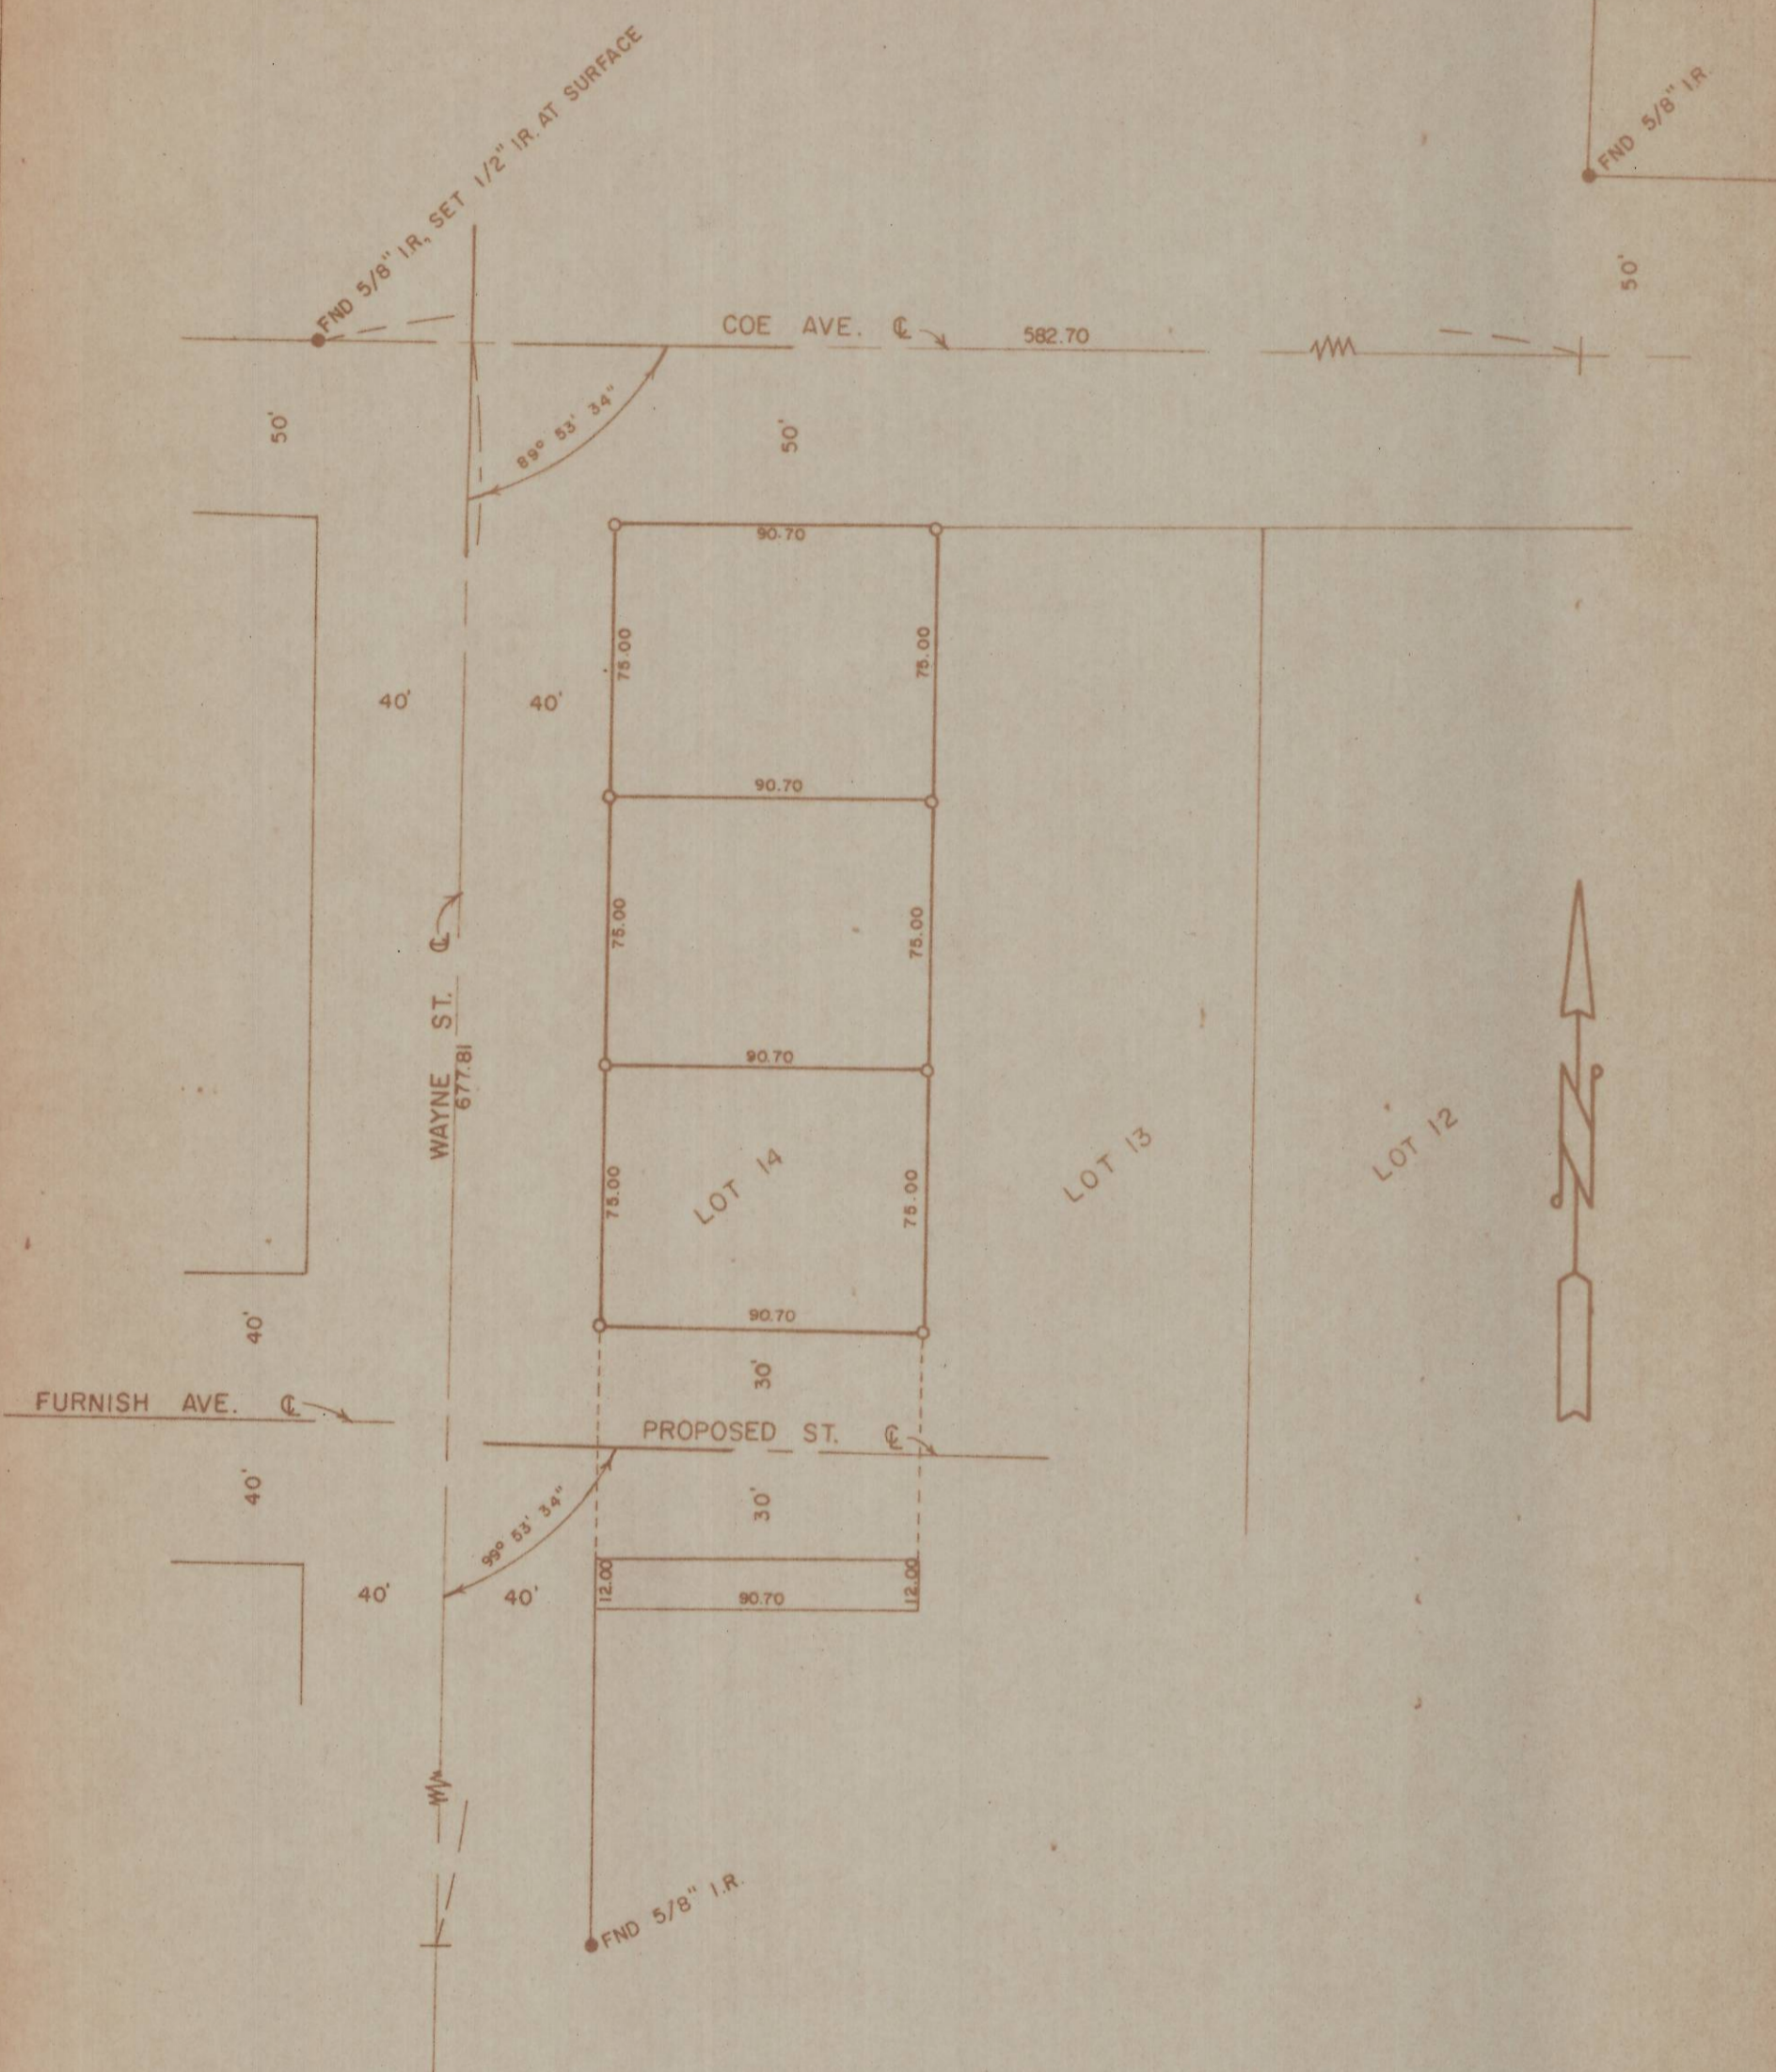

**SURVEY FOR CHUCK MARTIN**

LOCATION **SE 1/4** LOT 14, STANFIELD ORCHARD OUTLOTS

SEC **32** T **4** N. R **29** E. W.M. UMATILLA COUNTY OREGON

DATE **10-10-77**

SCALE **1" = 50'**

• MONUMENTS FOUND

(000) OF RECORD

○ IRON RODS SET 1/2"

JOB NO. **S7707215**

**EDWARDS SURVEYING**

567 3336

P.O. Box 760  
Hermiston, Ore

REGISTERED  
PROFESSIONAL  
LAND SURVEYOR

*G. Dennis Edwards*

OREGON  
JULY 18, 1971  
G. DENNIS EDWARDS  
951

O-83-A

O-83-A