


- BRASS CAP SET
- RES. ADD. MON
- TRAV. STA
- DIST. MEASURED

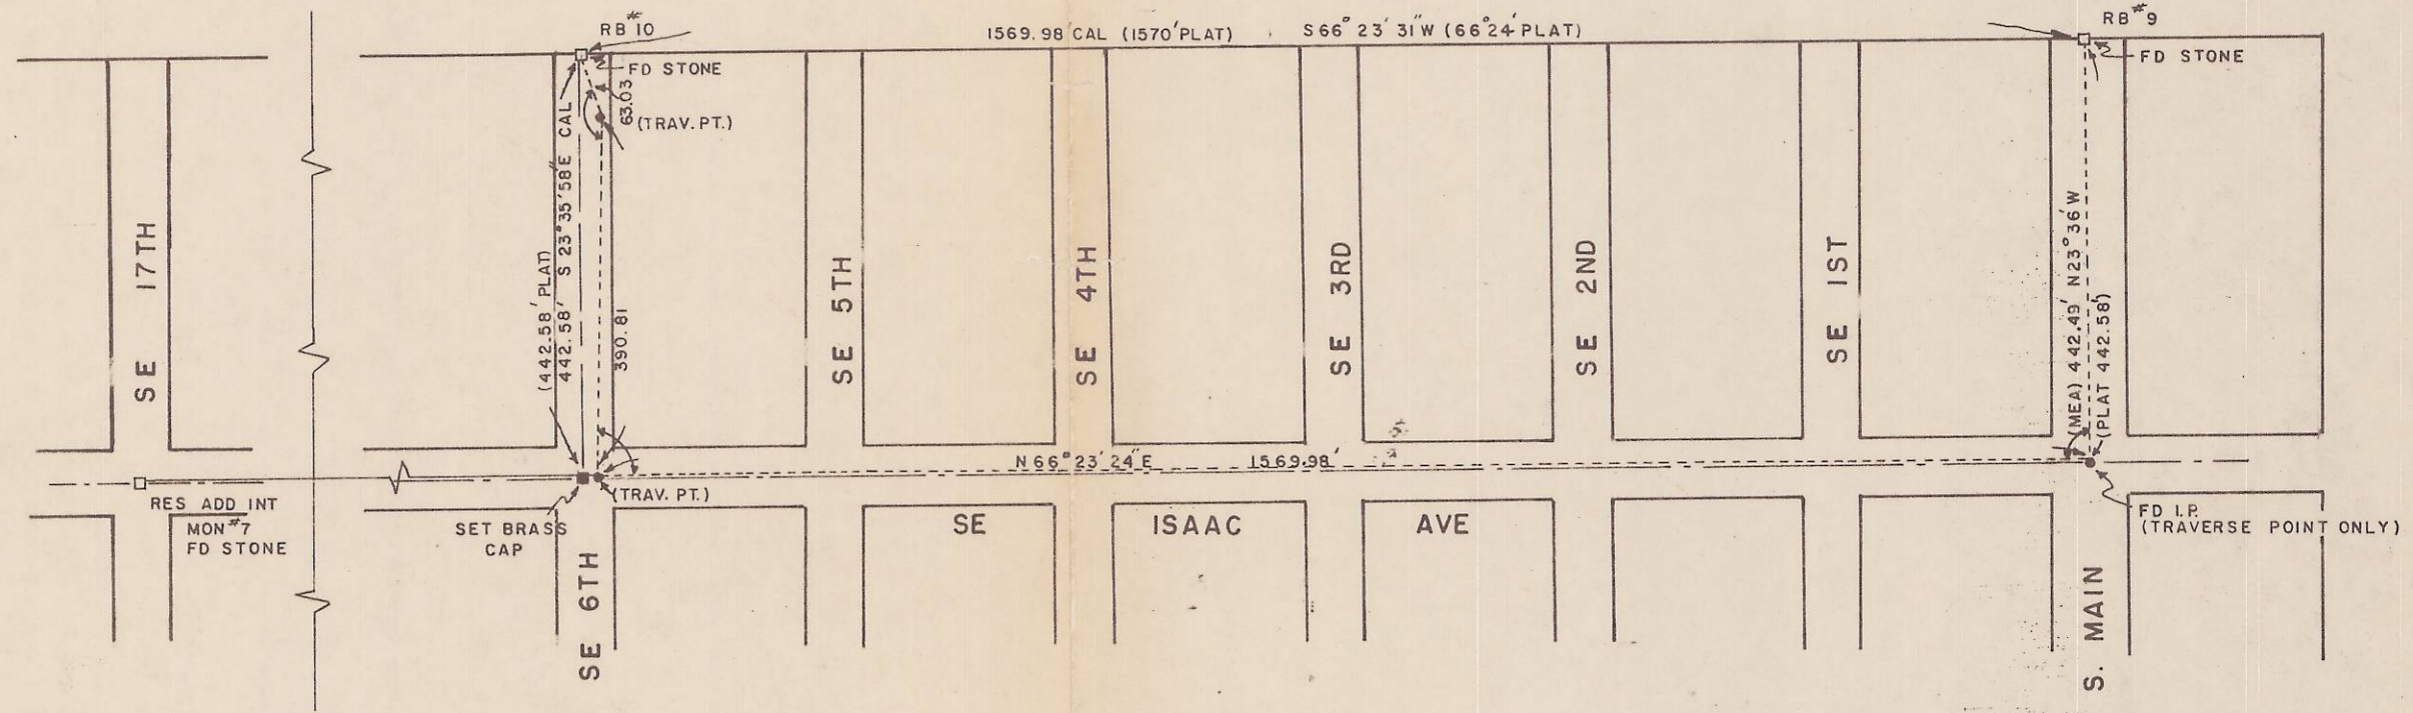

REMONUMENTATION FORM (R6-7100-57) FILED WITH COUNTY SURVEYOR

11-7664

SE 6TH & ISAAC
CONTROL SURVEY
DATE: 6-17-70 SCALE: 1"=200'

Q-353-A

Q-353-A

N 112 11
24 39 E