

SE 1/4 SW 1/4

S. H. R. W. - 395

Area To Be Irrigated  
10.56 Acres

Garage

House


Well

Chicken Pen

Barn

N. 37° 53' 20" W. 365.0'

1/4 6 Cor.  
2 1

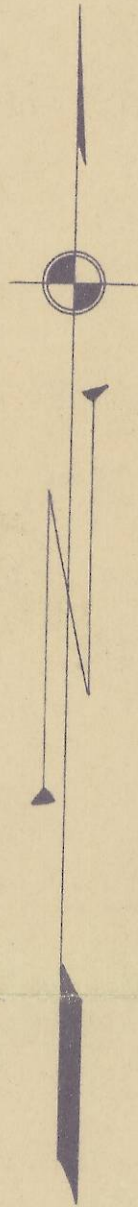

PLAT OF SURVEY  
FOR  
NEAL RIDDLE

LOCATION OF WELL  
AND LAND TO BE IRRIGATED

LOCATED IN THE SE 1/4 SW 1/4  
SECTION 16, T. 2 N., R. 32 E.W.M.

June 16, 1954

Scale 1" = 100'



Q-418-A

16 CD  
orig.

20-32-16C