

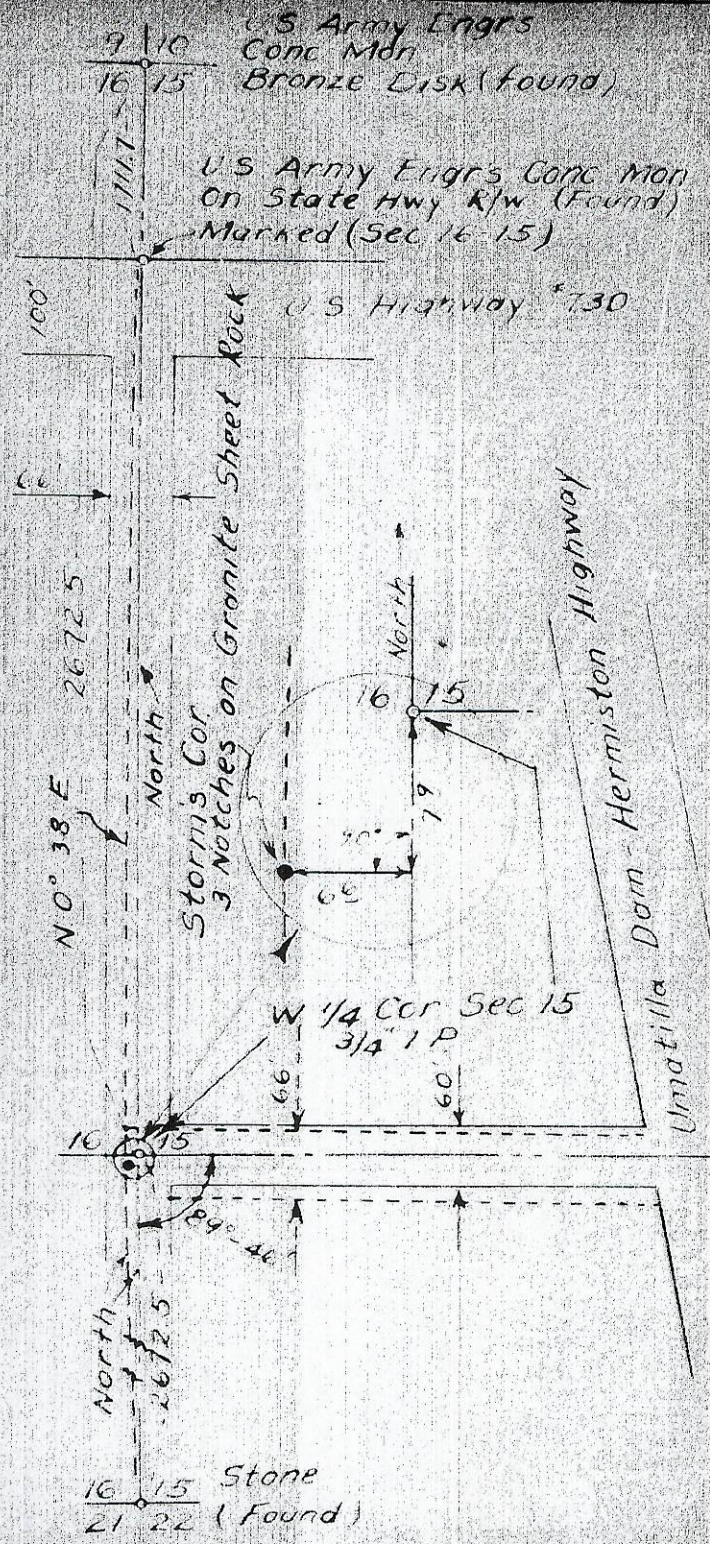


MAP
 SHOWING DISCREPANCIES IN SURVEY LINES
 ON VAN SLATTE PROP.
 IN S.W. 1/4 of N.W. 1/4 of SEC. 15, T. 5 N., R. 28 E., W.M.

SCALE 1" = 200'

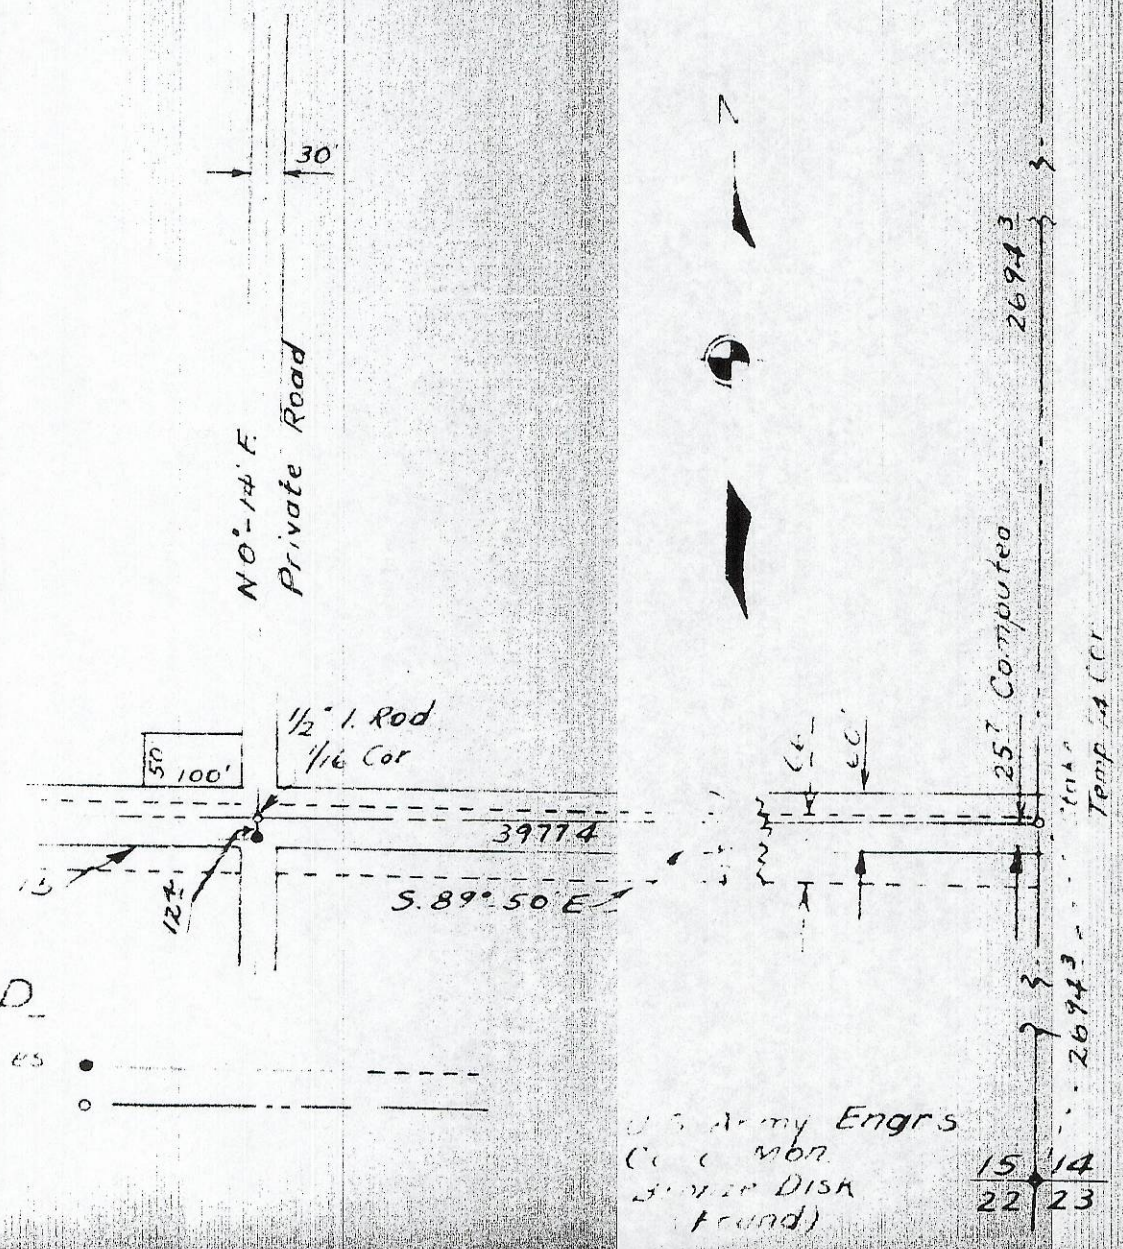

Verd R. Fraley
 No 183

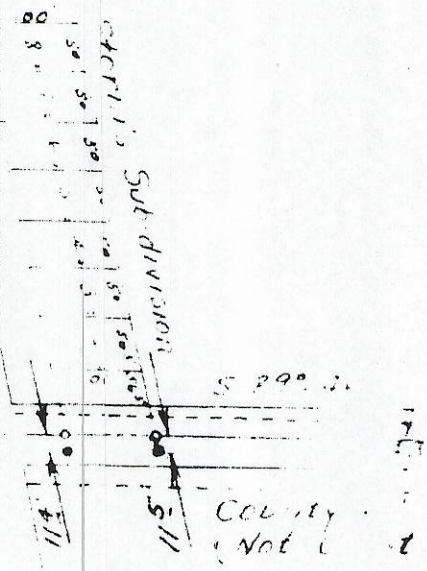

LEGEND

- Storm's Point
- Fialeys