


E. 1/4 Cor
Sec. 1, T2N.
R. 32 E.W.M.

Q-1050-A

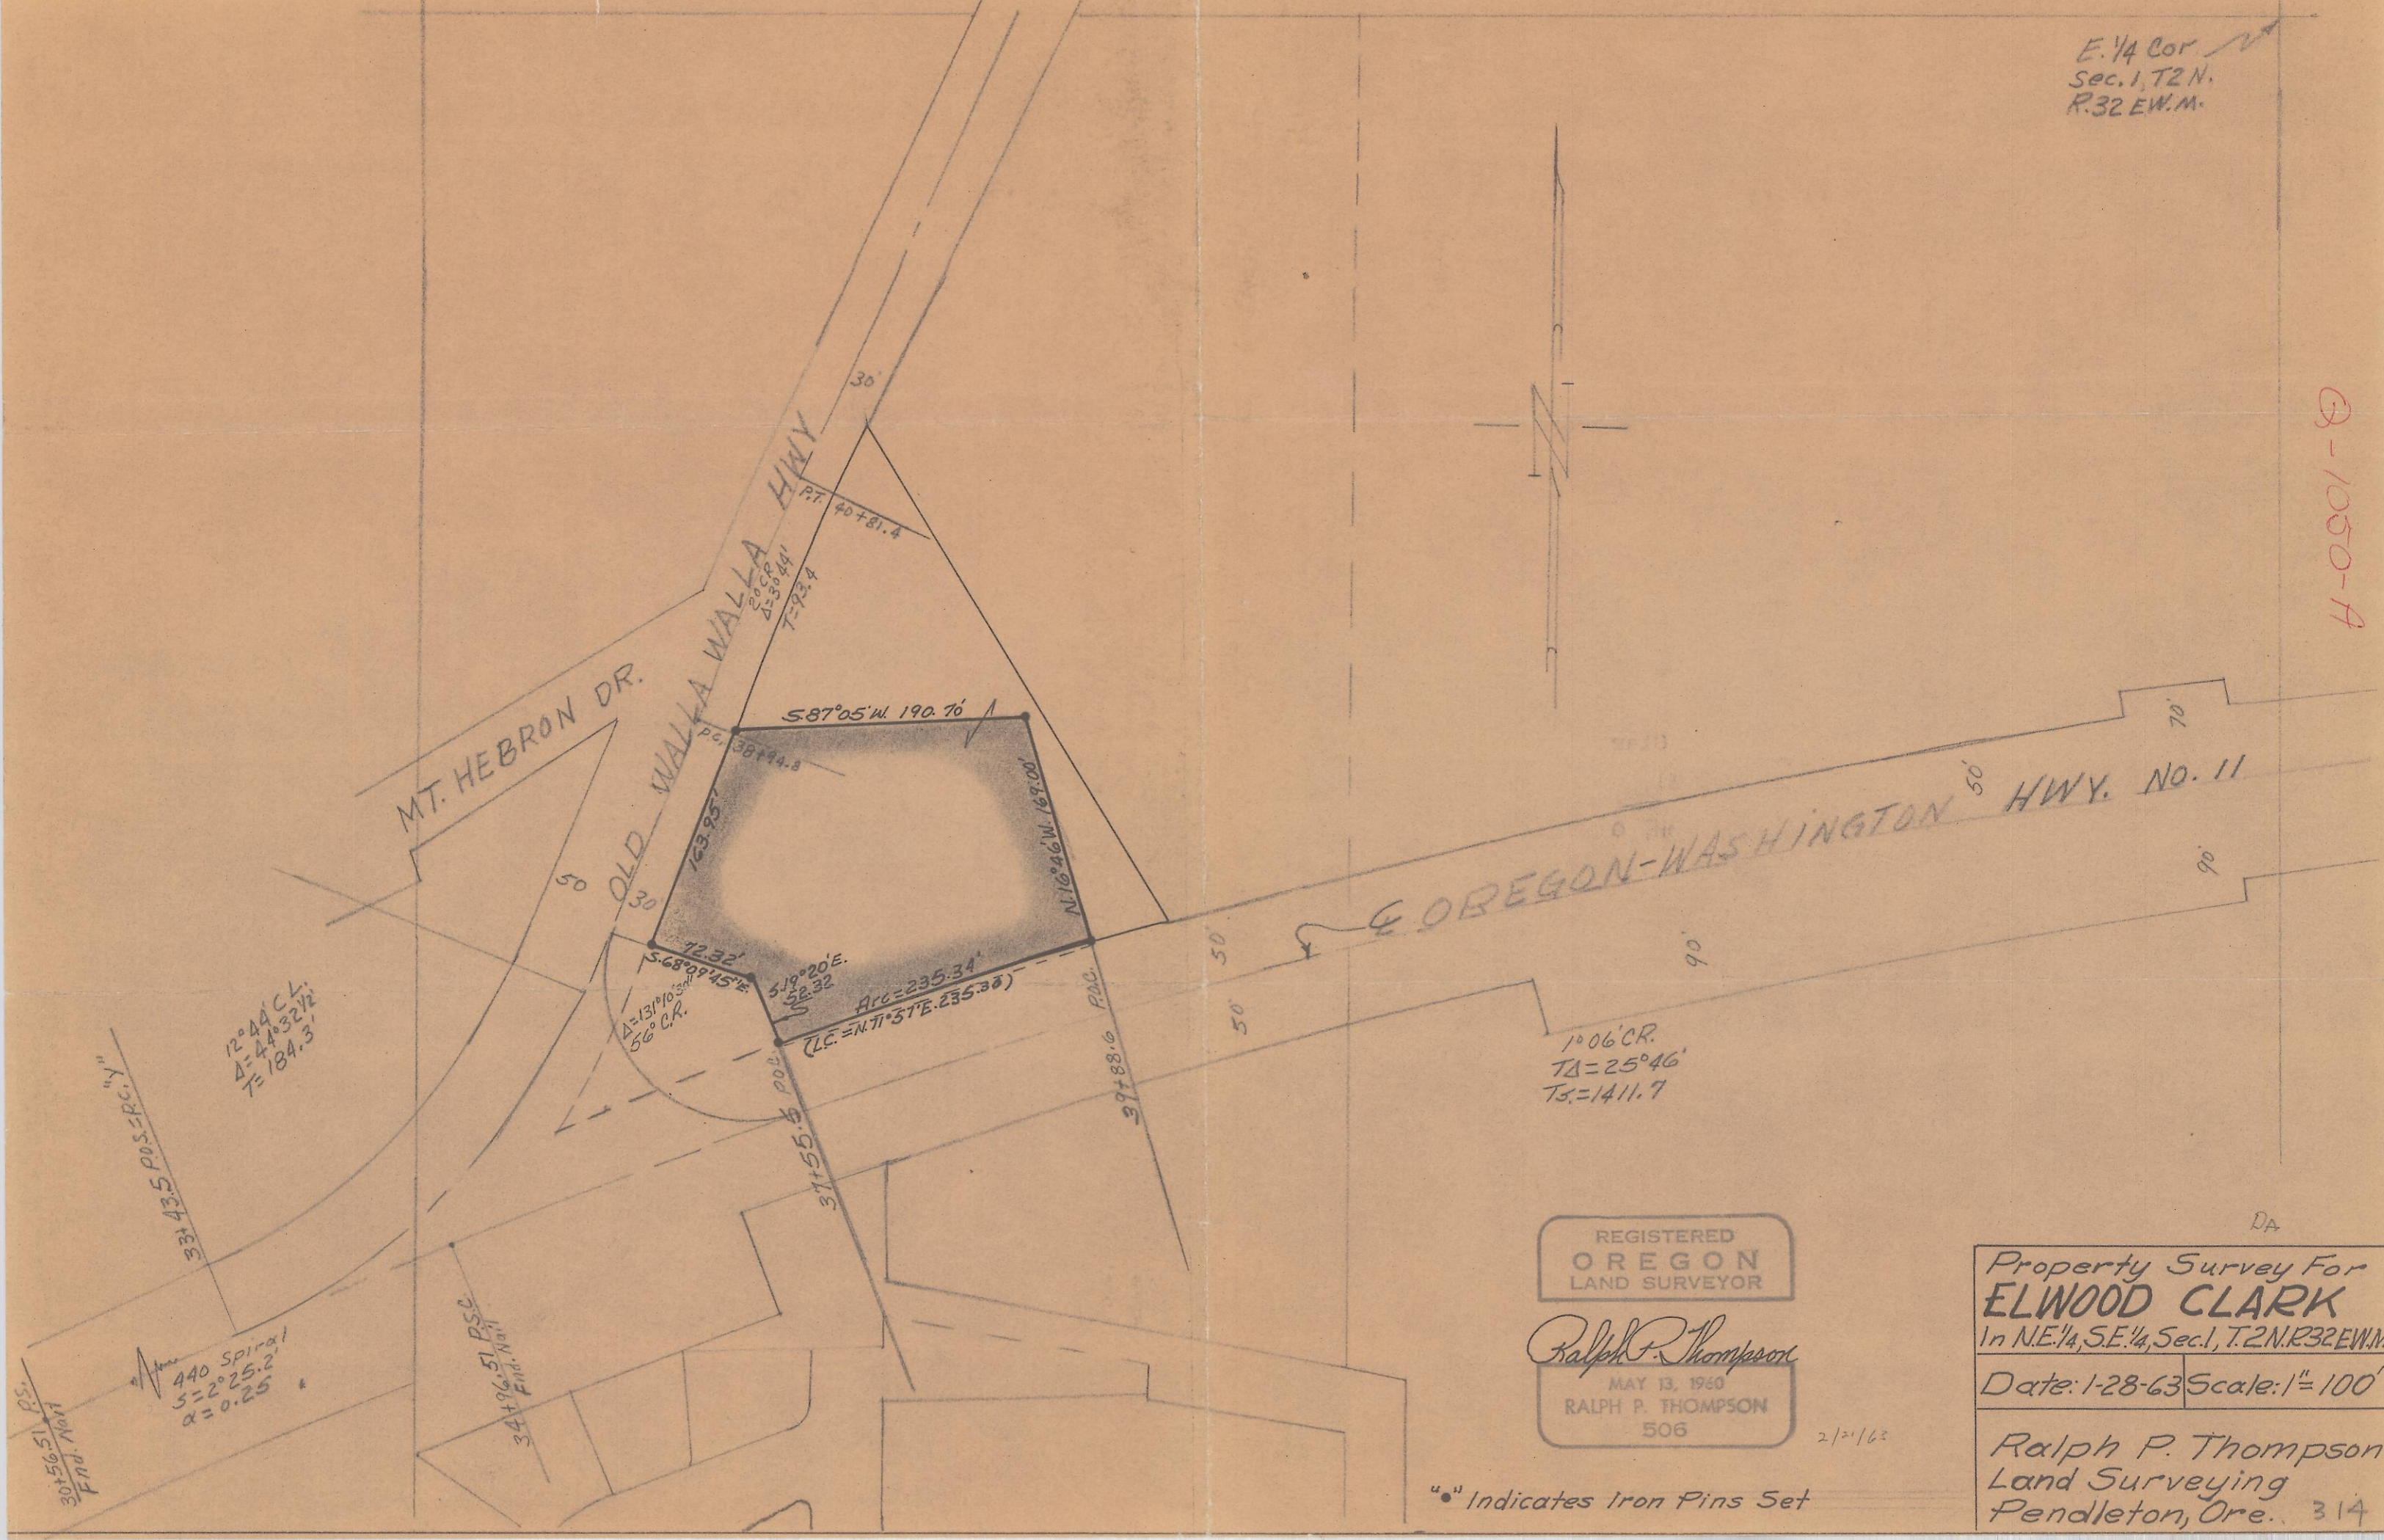

REGISTERED
OREGON
LAND SURVEYOR

Ralph P. Thompson

MAY 13, 1960
RALPH P. THOMPSON
506

2/21/63

Property Survey For
ELWOOD CLARK
In NE 1/4, SE 1/4, Sec. 1, T. 2N. R. 32E. W.M.

Date: 1-28-63 Scale: 1" = 100'

Ralph P. Thompson
Land Surveying
Pendleton, Ore. 314

"•" Indicates Iron Pins Set