


4 3
9 10

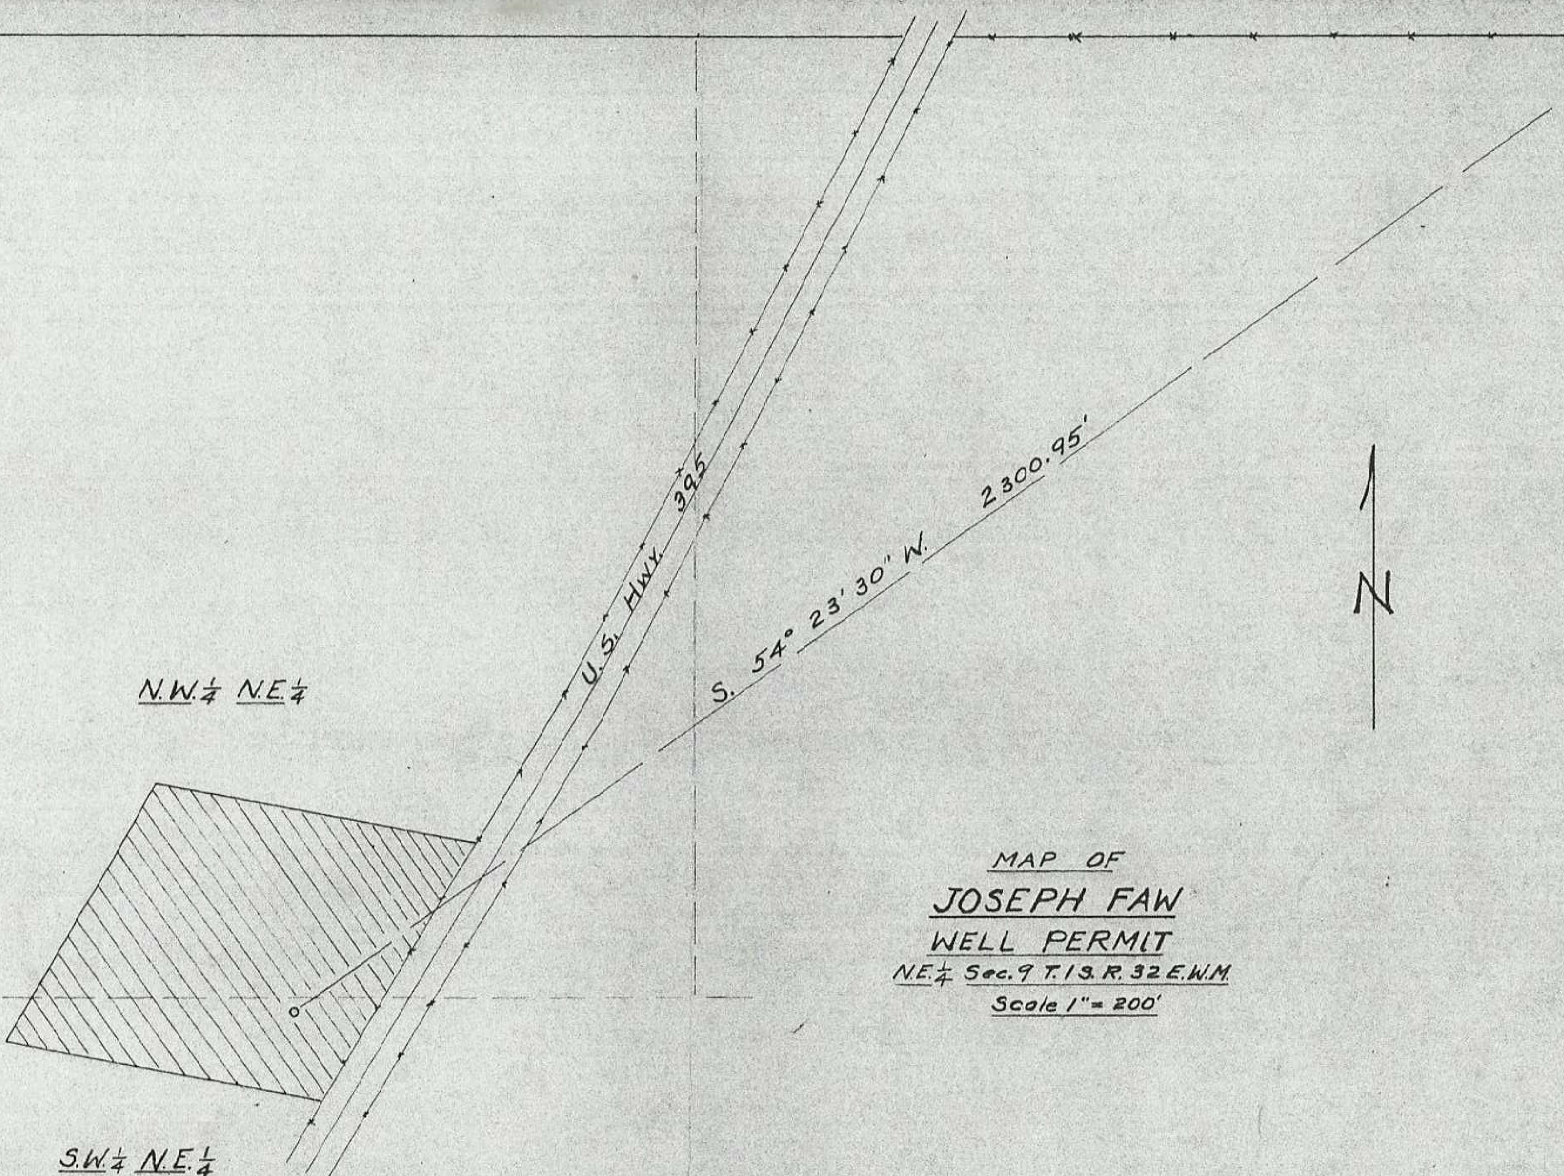

N.W. 1/4 N.E. 1/4

S.W. 1/4 N.E. 1/4

MAP OF
JOSEPH FAW
WELL PERMIT
N.E. 1/4 Sec. 9 T. 13. R. 32 E. W.M.
Scale 1" = 200'

Q-1659
-1001, 13, R32, 9