


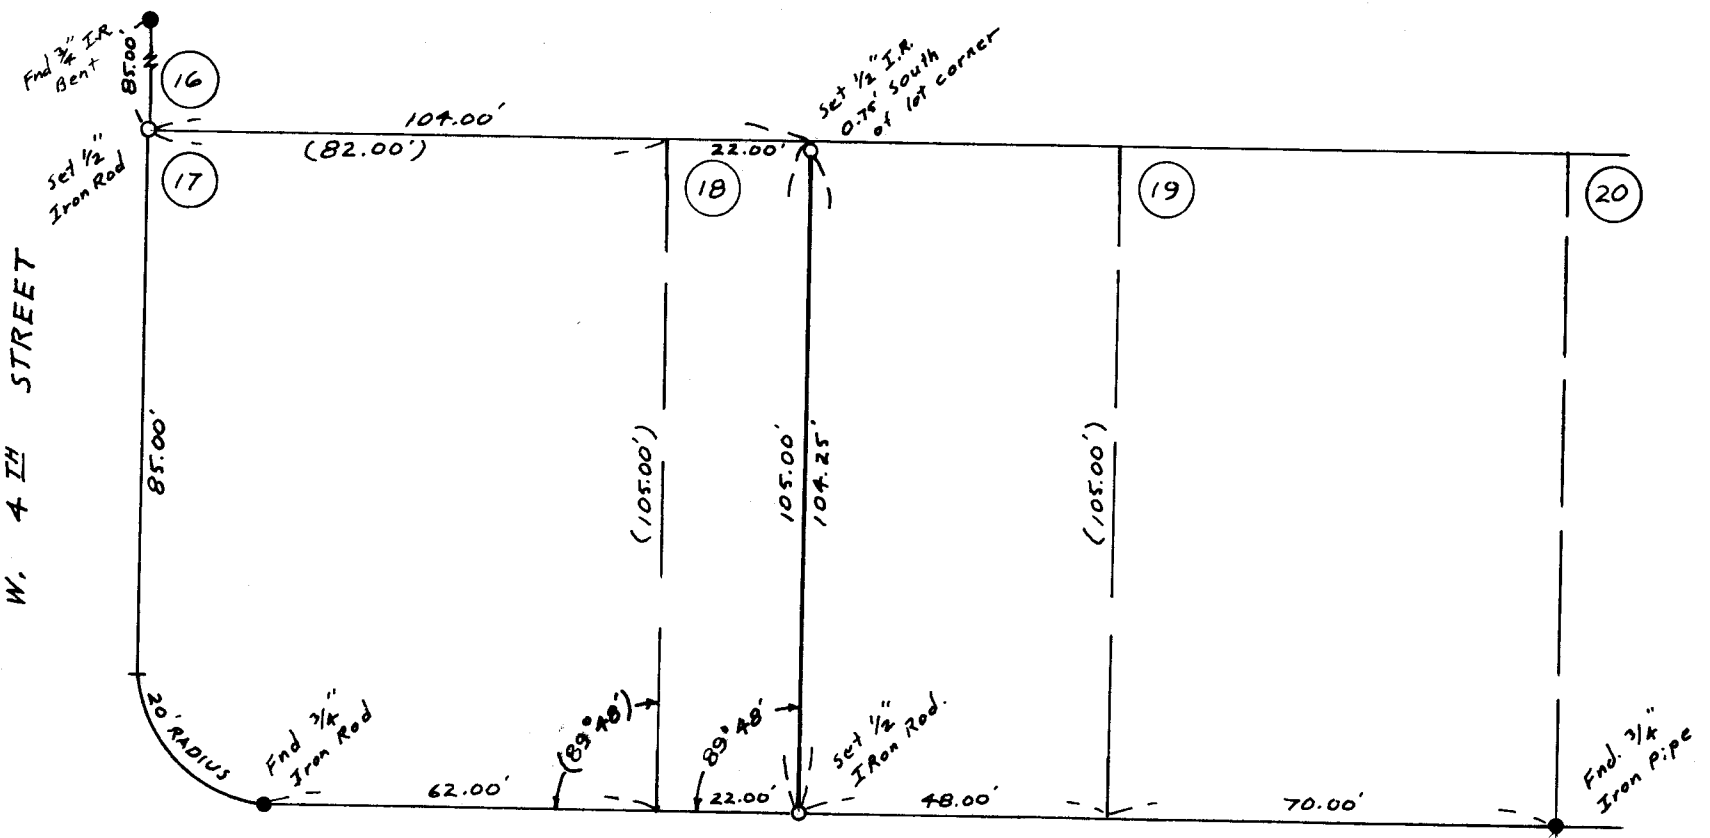

W. 4TH STREET



McKENZIE AVE.

The purpose of this survey is to stake the north & east property lines of Carper.
 The N.E. corner was set 0.75' south because of a fence.

REGISTERED
 PROFESSIONAL
 LAND SURVEYOR

J. Dennis Edwards

OREGON
 JULY 16, 1971
 G. DENNIS EDWARDS
 951

83-167-AY

SURVEY FOR B. CARPER
 IN B1K. 2, LAIRD ADD., IN NE 1/4
 NE 1/4, Sec 15, T4N, R28E, W.M.,
 City of HERMISTON, UMATILLA Co, OR.
 7/7/83 (000) of record
 Job # 58306049 Scale: 1" = 30'
 EDWARDS SURVEYING P.O. Box 763
 567-3336 HERMISTON, OR