


Section 21 Twn 2N, R32 E.W.M.



WEST LINE OF SECTION 21
1478.61

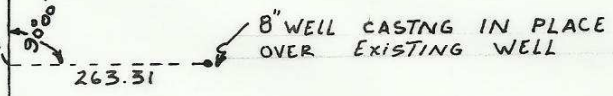

This is a copy traced (TT)
99-244-Ax (11-99)

| | |
|--|--------------------|
| SURVEY FOR WILLIAM D. EASLY | |
| Scale 1"=300' | Date: July 8, 1960 |
| STANLEY G. WALLULIS CONSULTING ENGINEER P.O. BOX 91 PENDLETON, OREGON | |