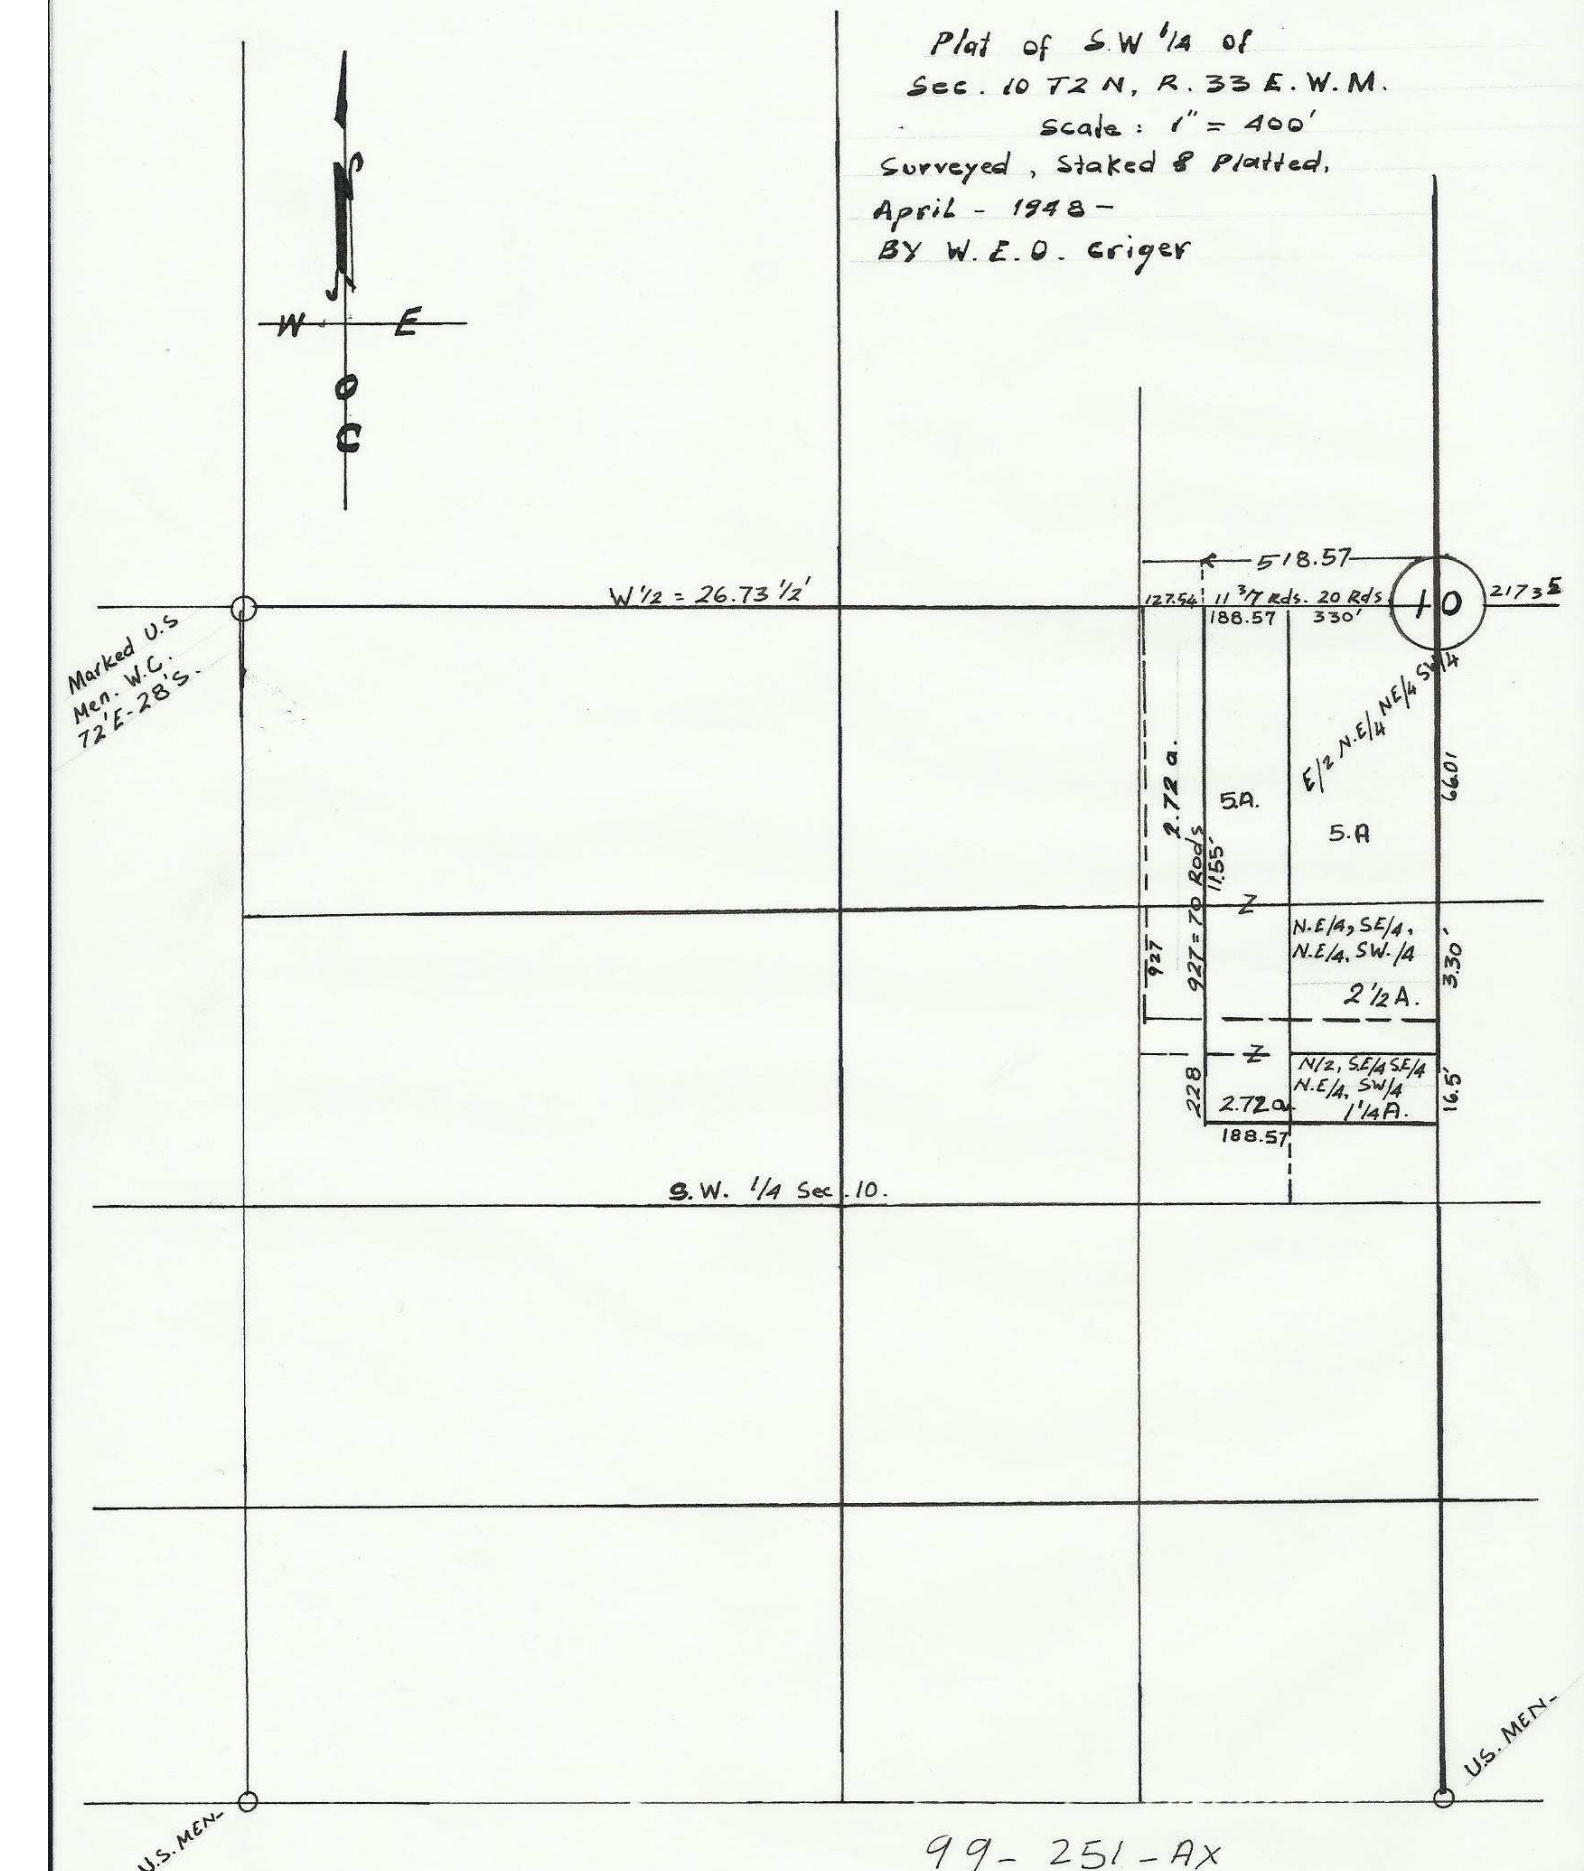

99-251-AX

This is a traced copy (TT) oct 25, 99.