

WAYNE HARRIS CO. INC.


ENGINEERS - SURVEYORS PENDLETON, ORE

SCALE	DATE	DWN	CHK	DWG. NO
1"=50'	9-7-78	MM	MM	78-418A

SURVEY FOR A.C. BECHDOLT
PENDLETON

BRASS CAP

at NW 5TH & HORN

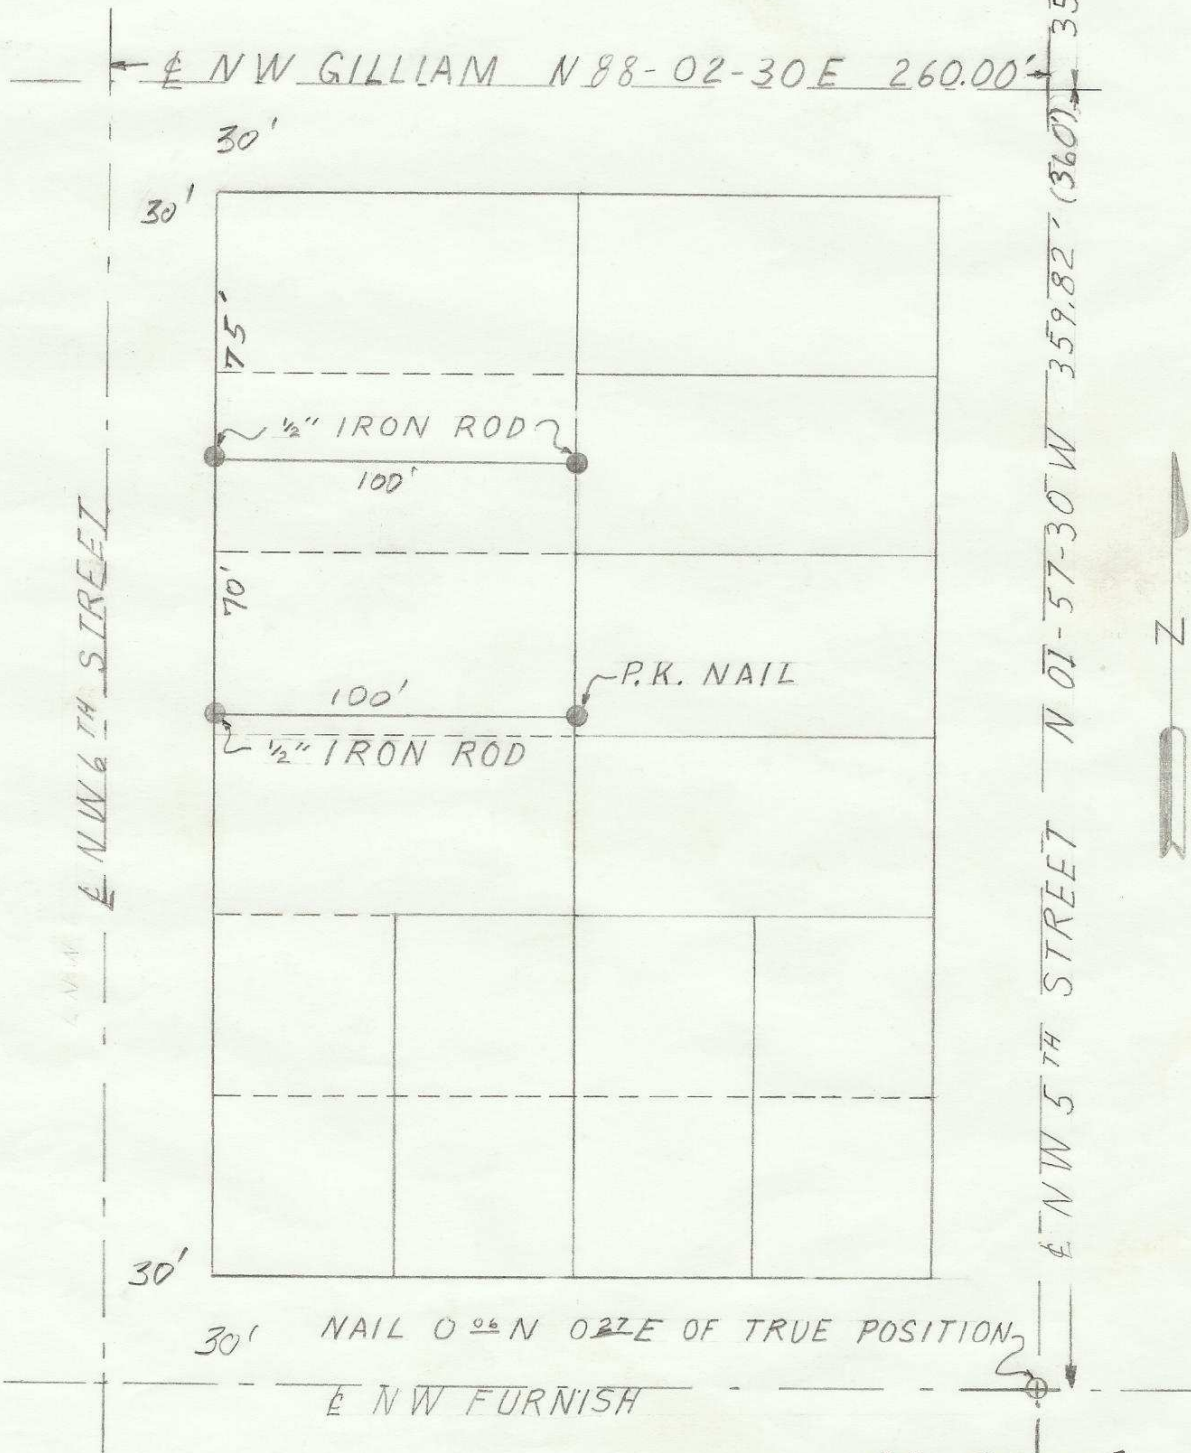

02-220-Ax

T2NR32 Sec. 03 DC

78-418-A