

Section 28
Section 27




I, J.C. Payne, certify
that this map was compiled
from notes of a field survey
made August 31, 1955.

J.C. Payne

Scale
1" = 100 feet

Note: Evidence of old
bridge approach on
Road # 403, found.

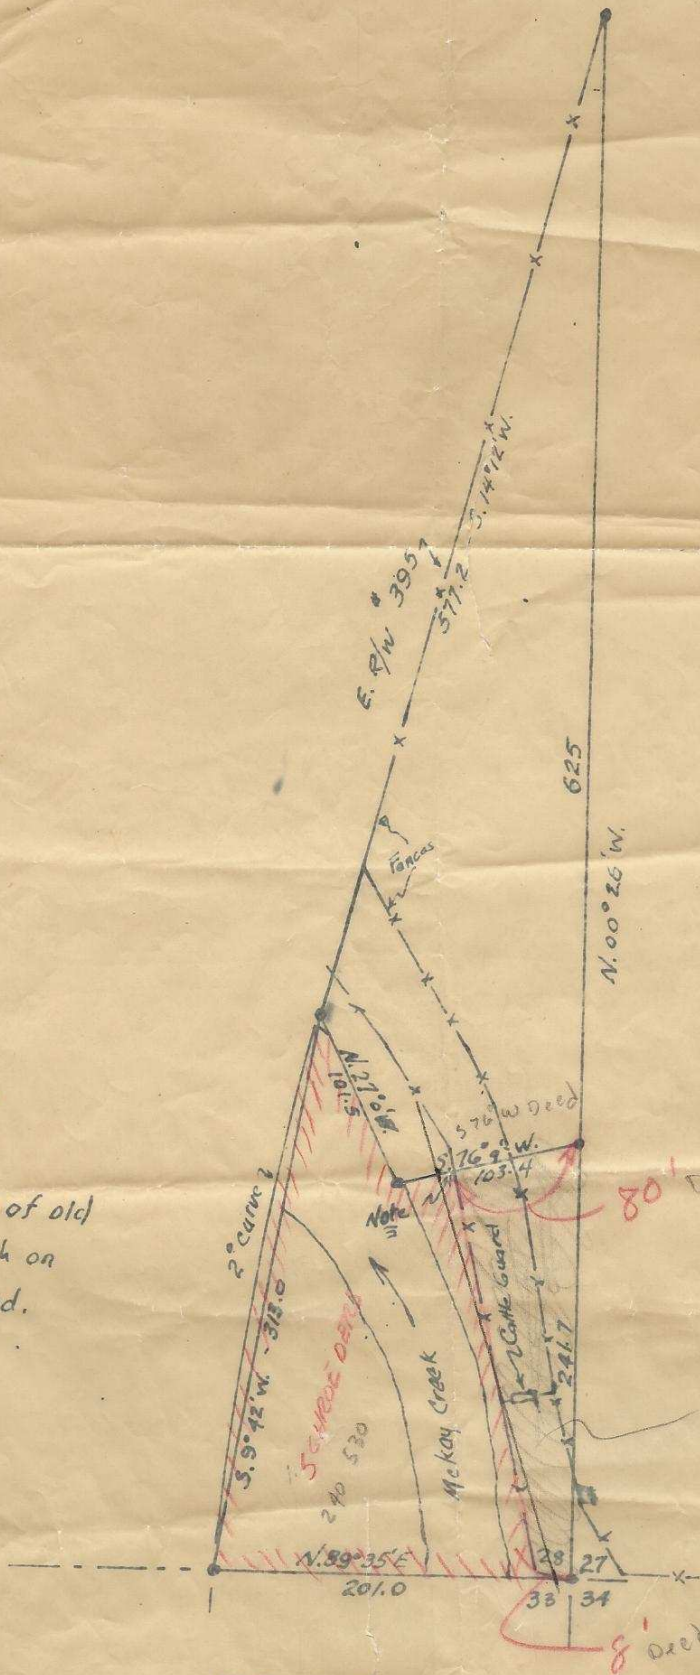

T. 2N., R. 32E. W.M.

04-181-A8