


TYLER AVENUE



5' UTILITY EASEMENT
ADJACENT TO ALL LOT LINES

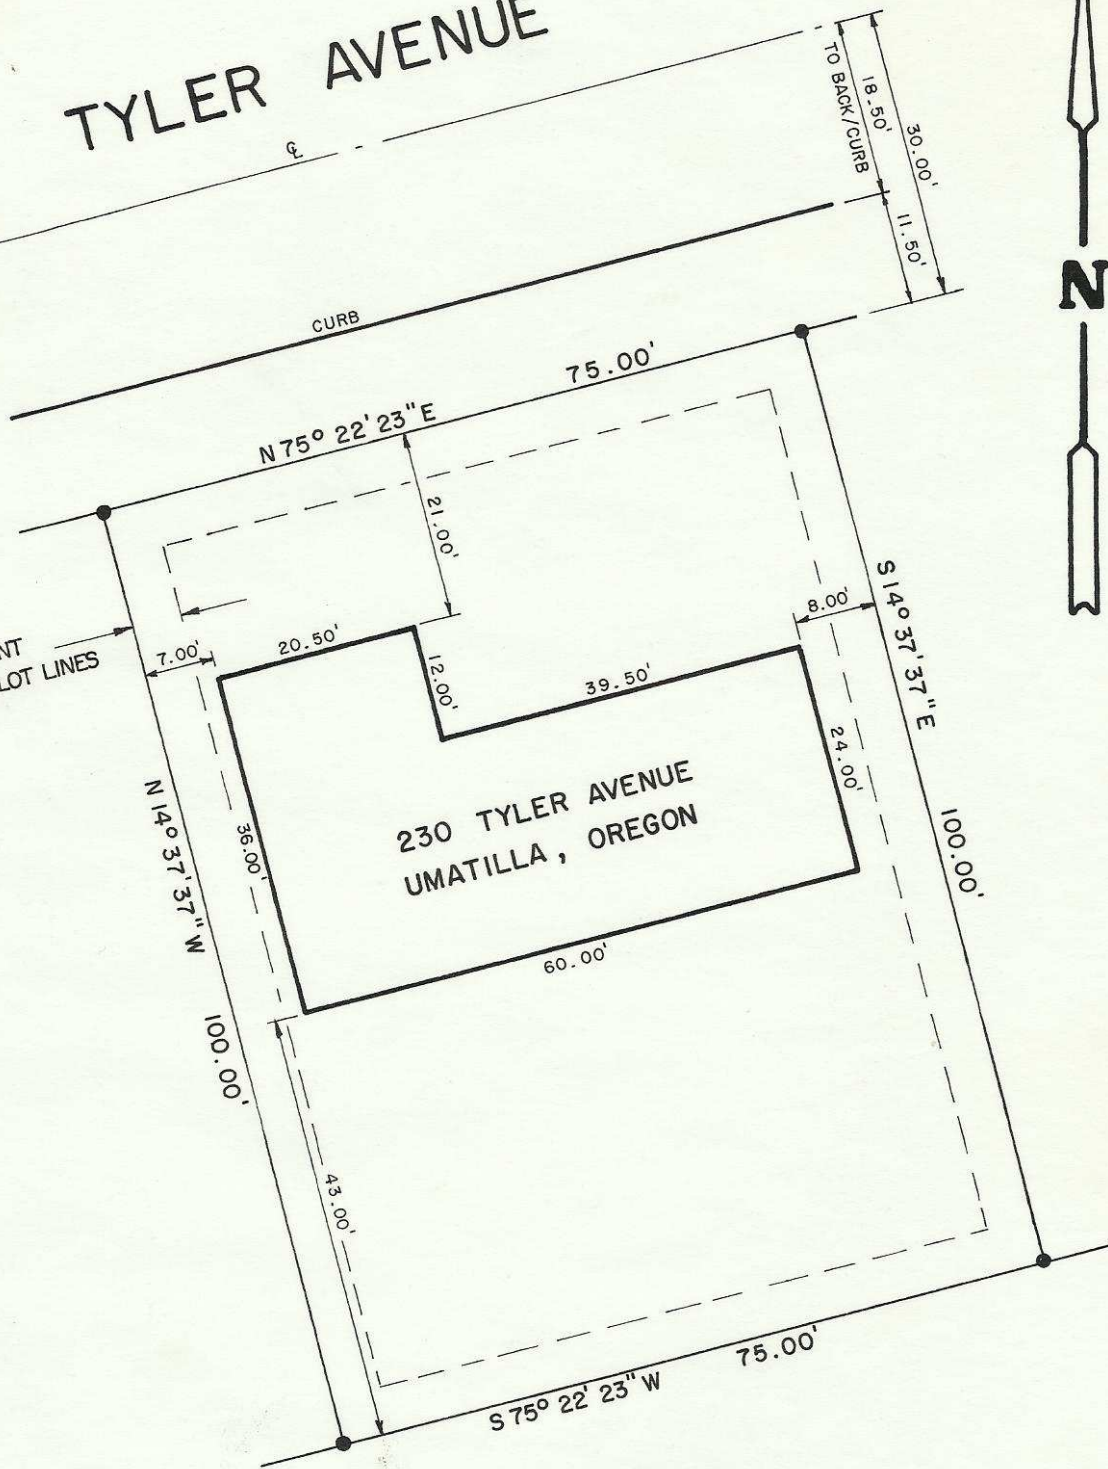


230 TYLER AVENUE
UMATILLA, OREGON

TSN 28 20 BB

NORPA DEVELOPMENT, INC. HERMISTON, ORE.

LOT SURVEY

LOT 3, BLOCK 4 CONFORTHS FIRST ADDITION

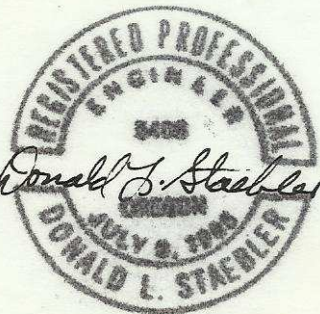

Donald L. Staehler

04-203-Ax

DESIGN	D. N.	CHK	D. S.	SCALE	1" = 20'	DATE	8-5-77
DRAFT	D. N.	APP		JO		REV	

OF