


Plat showing
 Part of Block "A" of Hermiston Orchard Addition
 to the town, now City, of Hermiston, Oregon.
 Surveyed, staked, & platted, Feb. 19 52.
 By W. E. O. Criger.
 Scale 1 inch = 100 Feet.

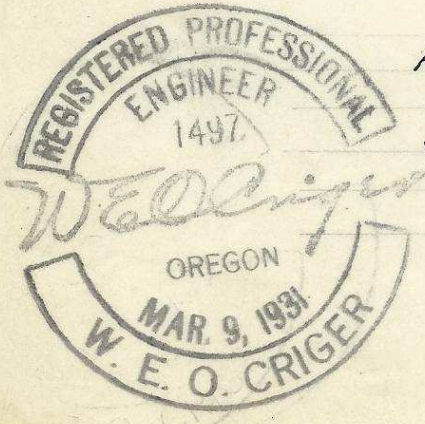

4N28 11DA

06-96-Ax

Frank Seeliger - P.O. Box 1043 - Hermiston -