

S. W. 3 / 4 St.

60'

120

80

60

60

5

Ph. 3354.

14

15

16

120.

17

John Haney
No. 3045

80


60

60

60

50'

S. W. Jay Ave.

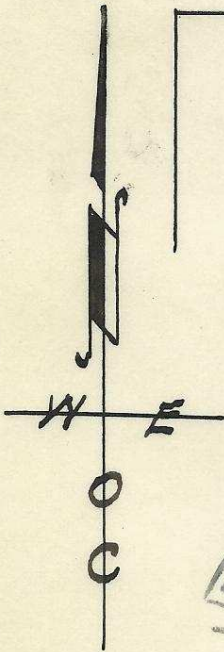

Plat Showing
 a part of Block 5 - Including Lot 16,
 in Sherwood Heights.
 Addition to City of Pendleton, Ore.
 Surveyed, Staked & platted, Apr. 1953.
 By W. E. O. Criger - Scale 1" = 50'



2N32 16AB

06-121-AV