S.W. Isaacs Ave. 60 Ft. Wide. N. 66°24' E.

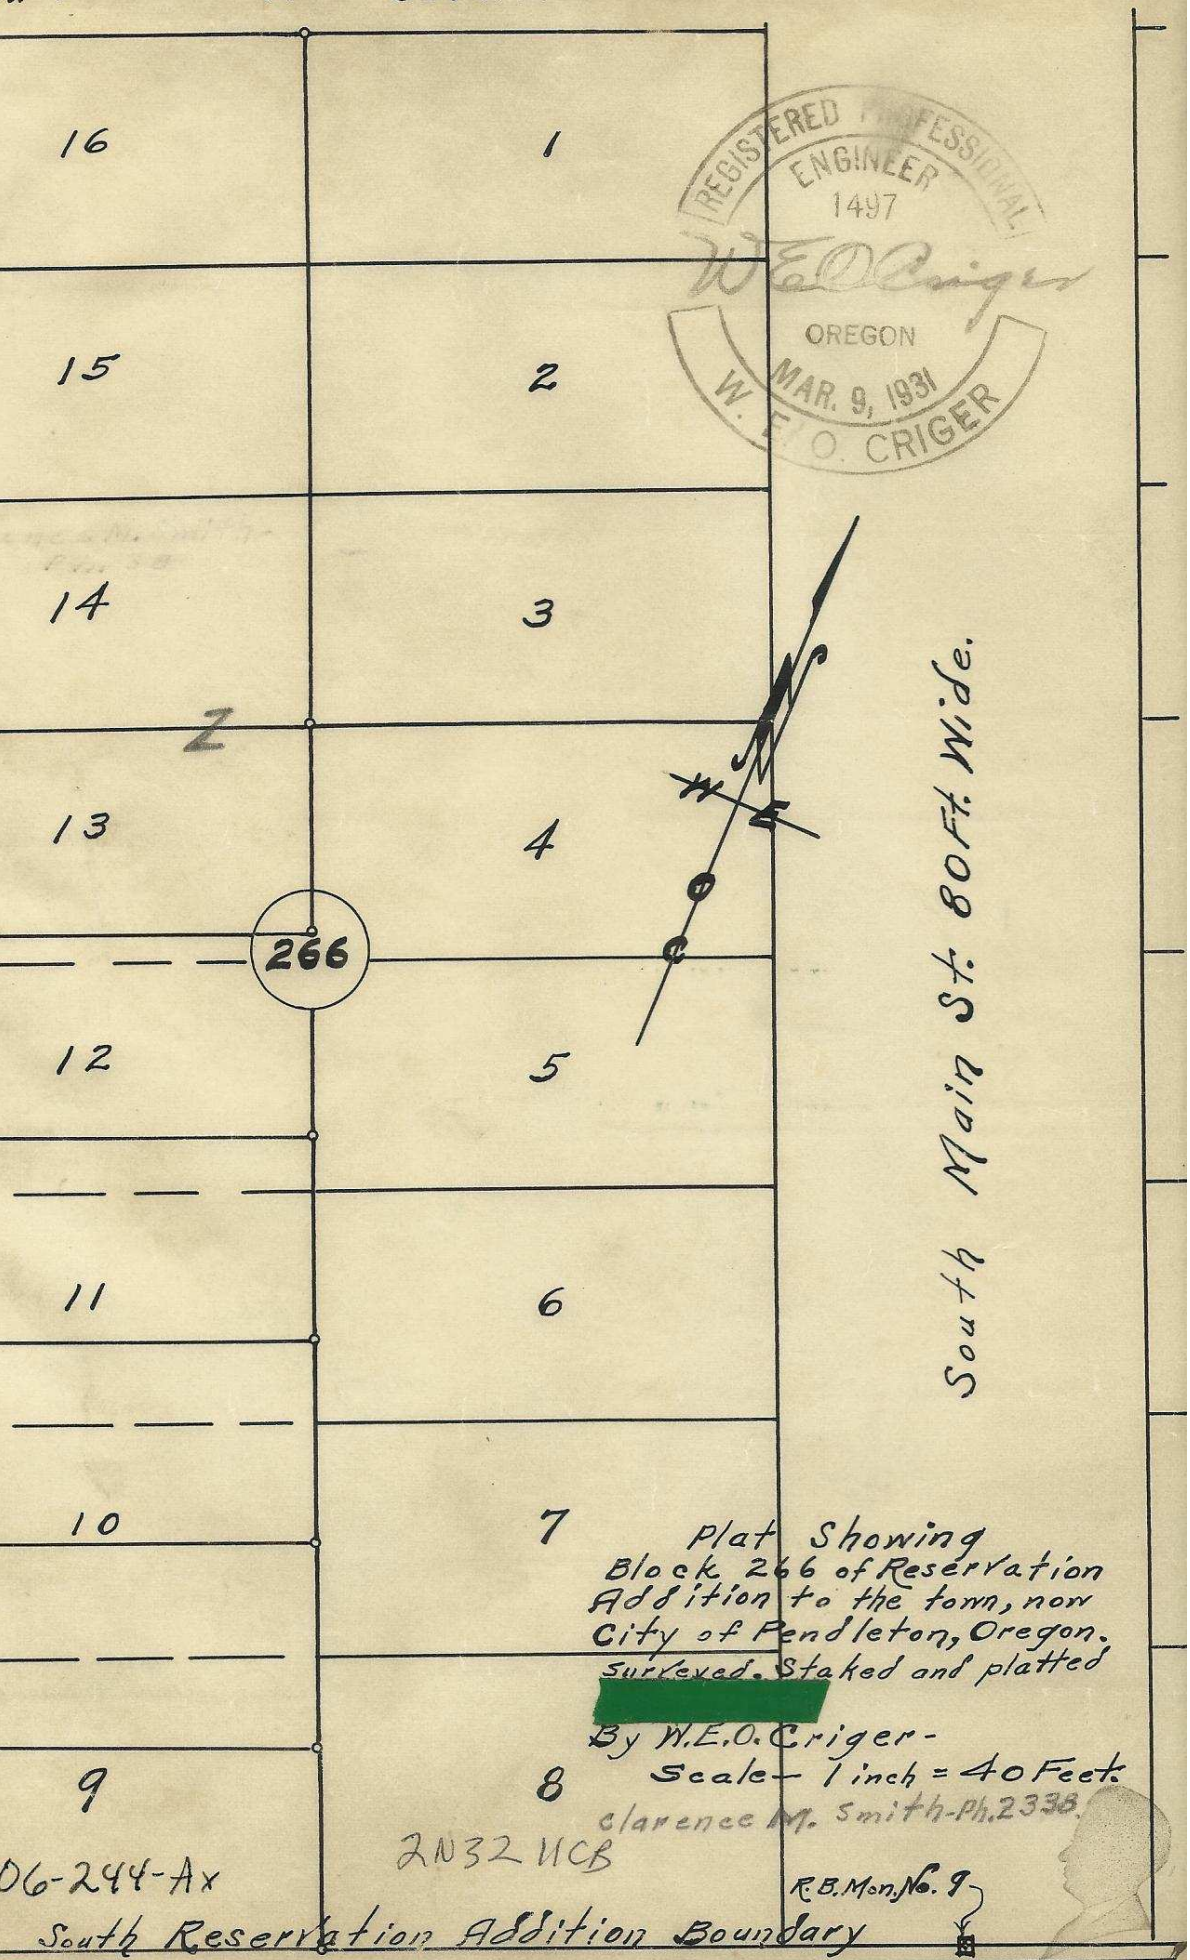

REGISTERED PROFESSIONAL ENGINEER 1497 W.E.O. Criger OREGON MAR. 9, 1931 W. E. O. CRIGER

Plat Showing
Block 266 of Reservation
Addition to the town, now
City of Pendleton, Oregon.
surveyed. Staked and platted
[redacted]
By W.E.O. Criger-
Scale— 1 inch = 40 Feet.
Clarence M. Smith-Ph. 2338

2N32 UCB

06-244-Ax

R.B. Mon. No. 9

South Reservation Addition Boundary

(4)