


60

60


S. W. Isaac Ave.

60

60

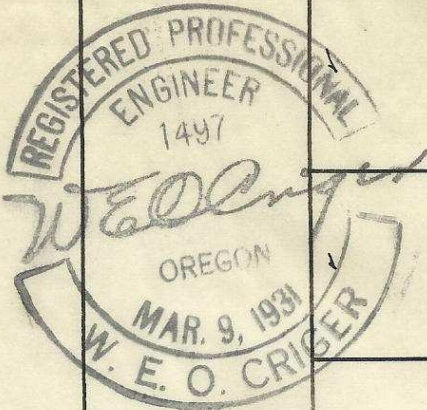

S. W. 4<sup>th</sup> St.

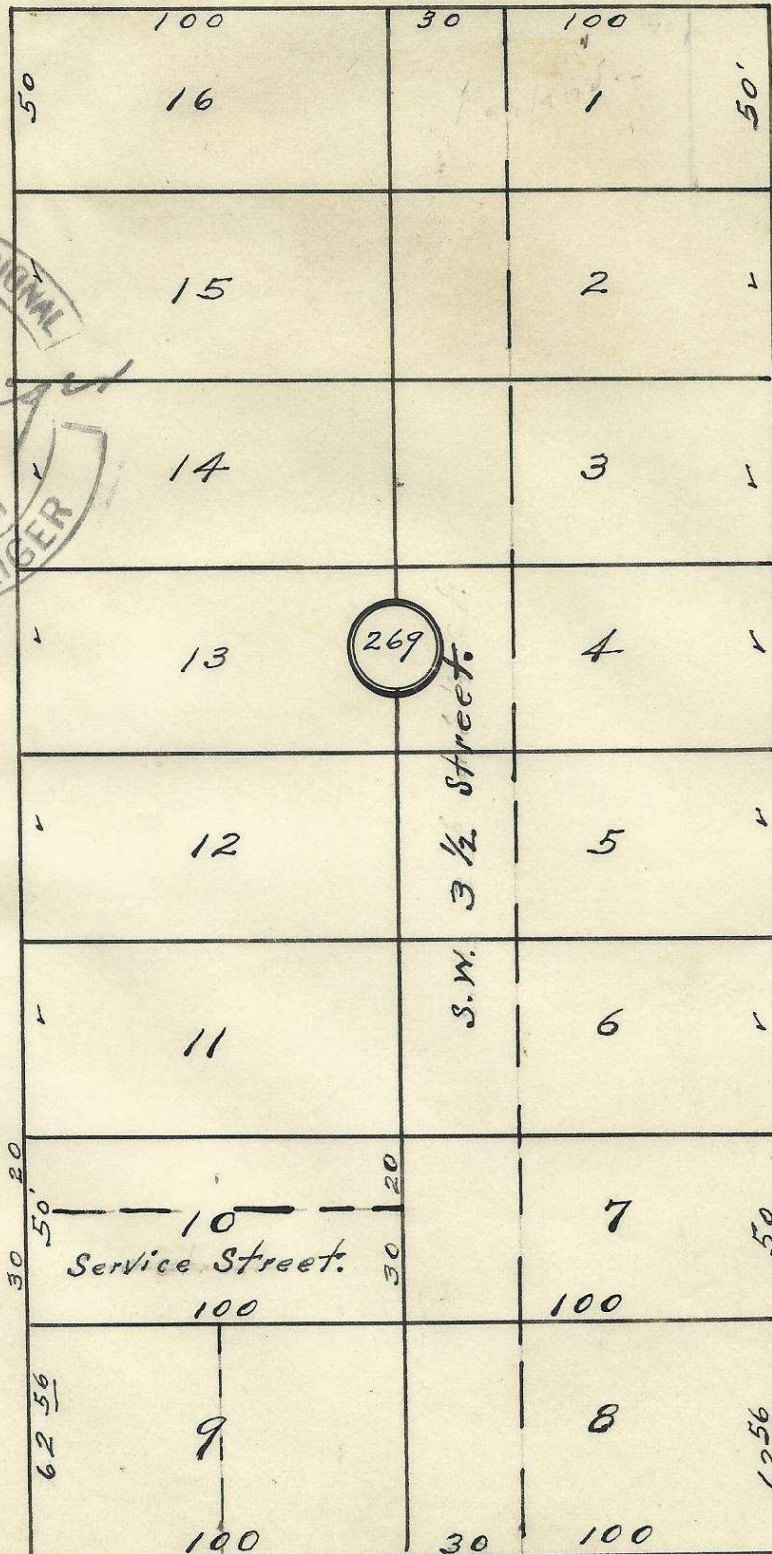

Vacated + Ord. 1137 July 9, 1944.

S. W. 3<sup>rd</sup> St.

Plat showing  
Block 269 of Reservation  
Addition to the town,  
Now City of Pendleton,  
Oregon -  
Surveyed, staked & platted  
March - 1953 - By W. E. O. Crigger  
Scale: 1" = 50'

South Boundary Res. Add.

4N28 11CB

06-245-Ax