


S. W. 7th St.

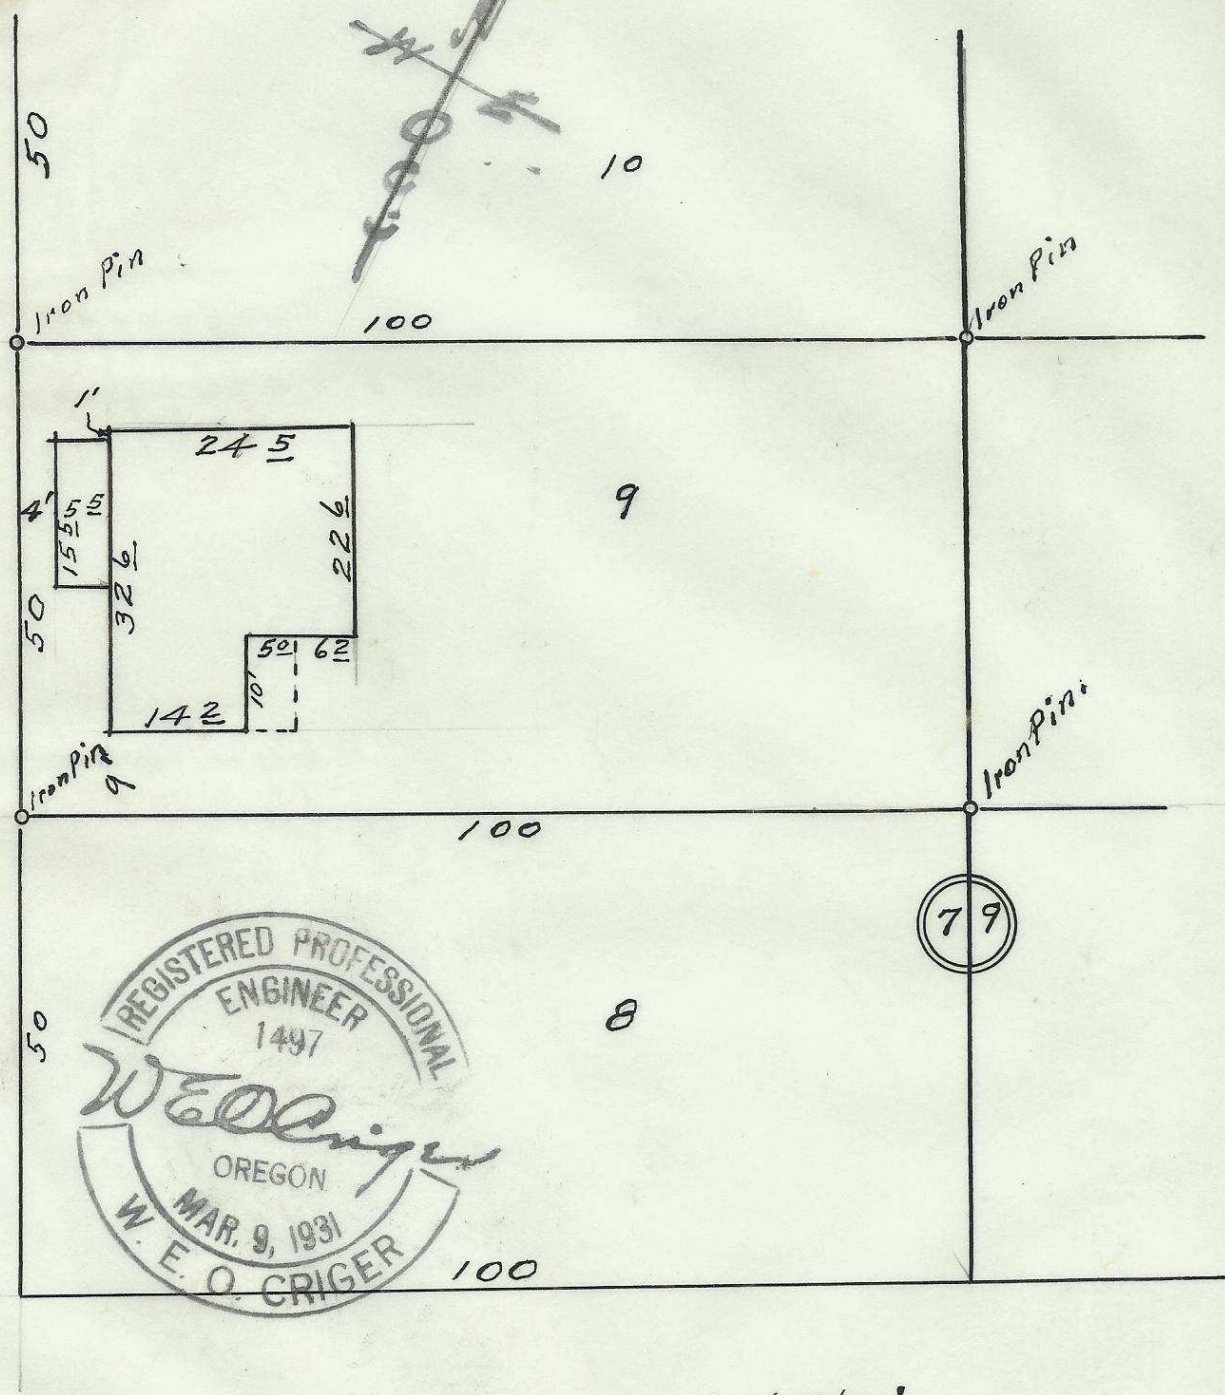

Plat Showing
 Part of Block 79 - Reservation
 Addition to the town,
 Now City of Pendleton, Ore.

S. W. Frazier

surveyed, staked & platted,
 August 1934 - By W. E. O. Criger,
 Scale: 1" = 20'

2N32 10AD

06-253-Ax

3