


Plat of Lot 5 Block 8 of Cump's
 Addition to City of Pendleton, Ore.
 Scale: 1 inch = 20 Feet.

Surveyed, staked and platted May-1951-
 By W.E.O. Criger. -
 Geo. Woodward. -
 4

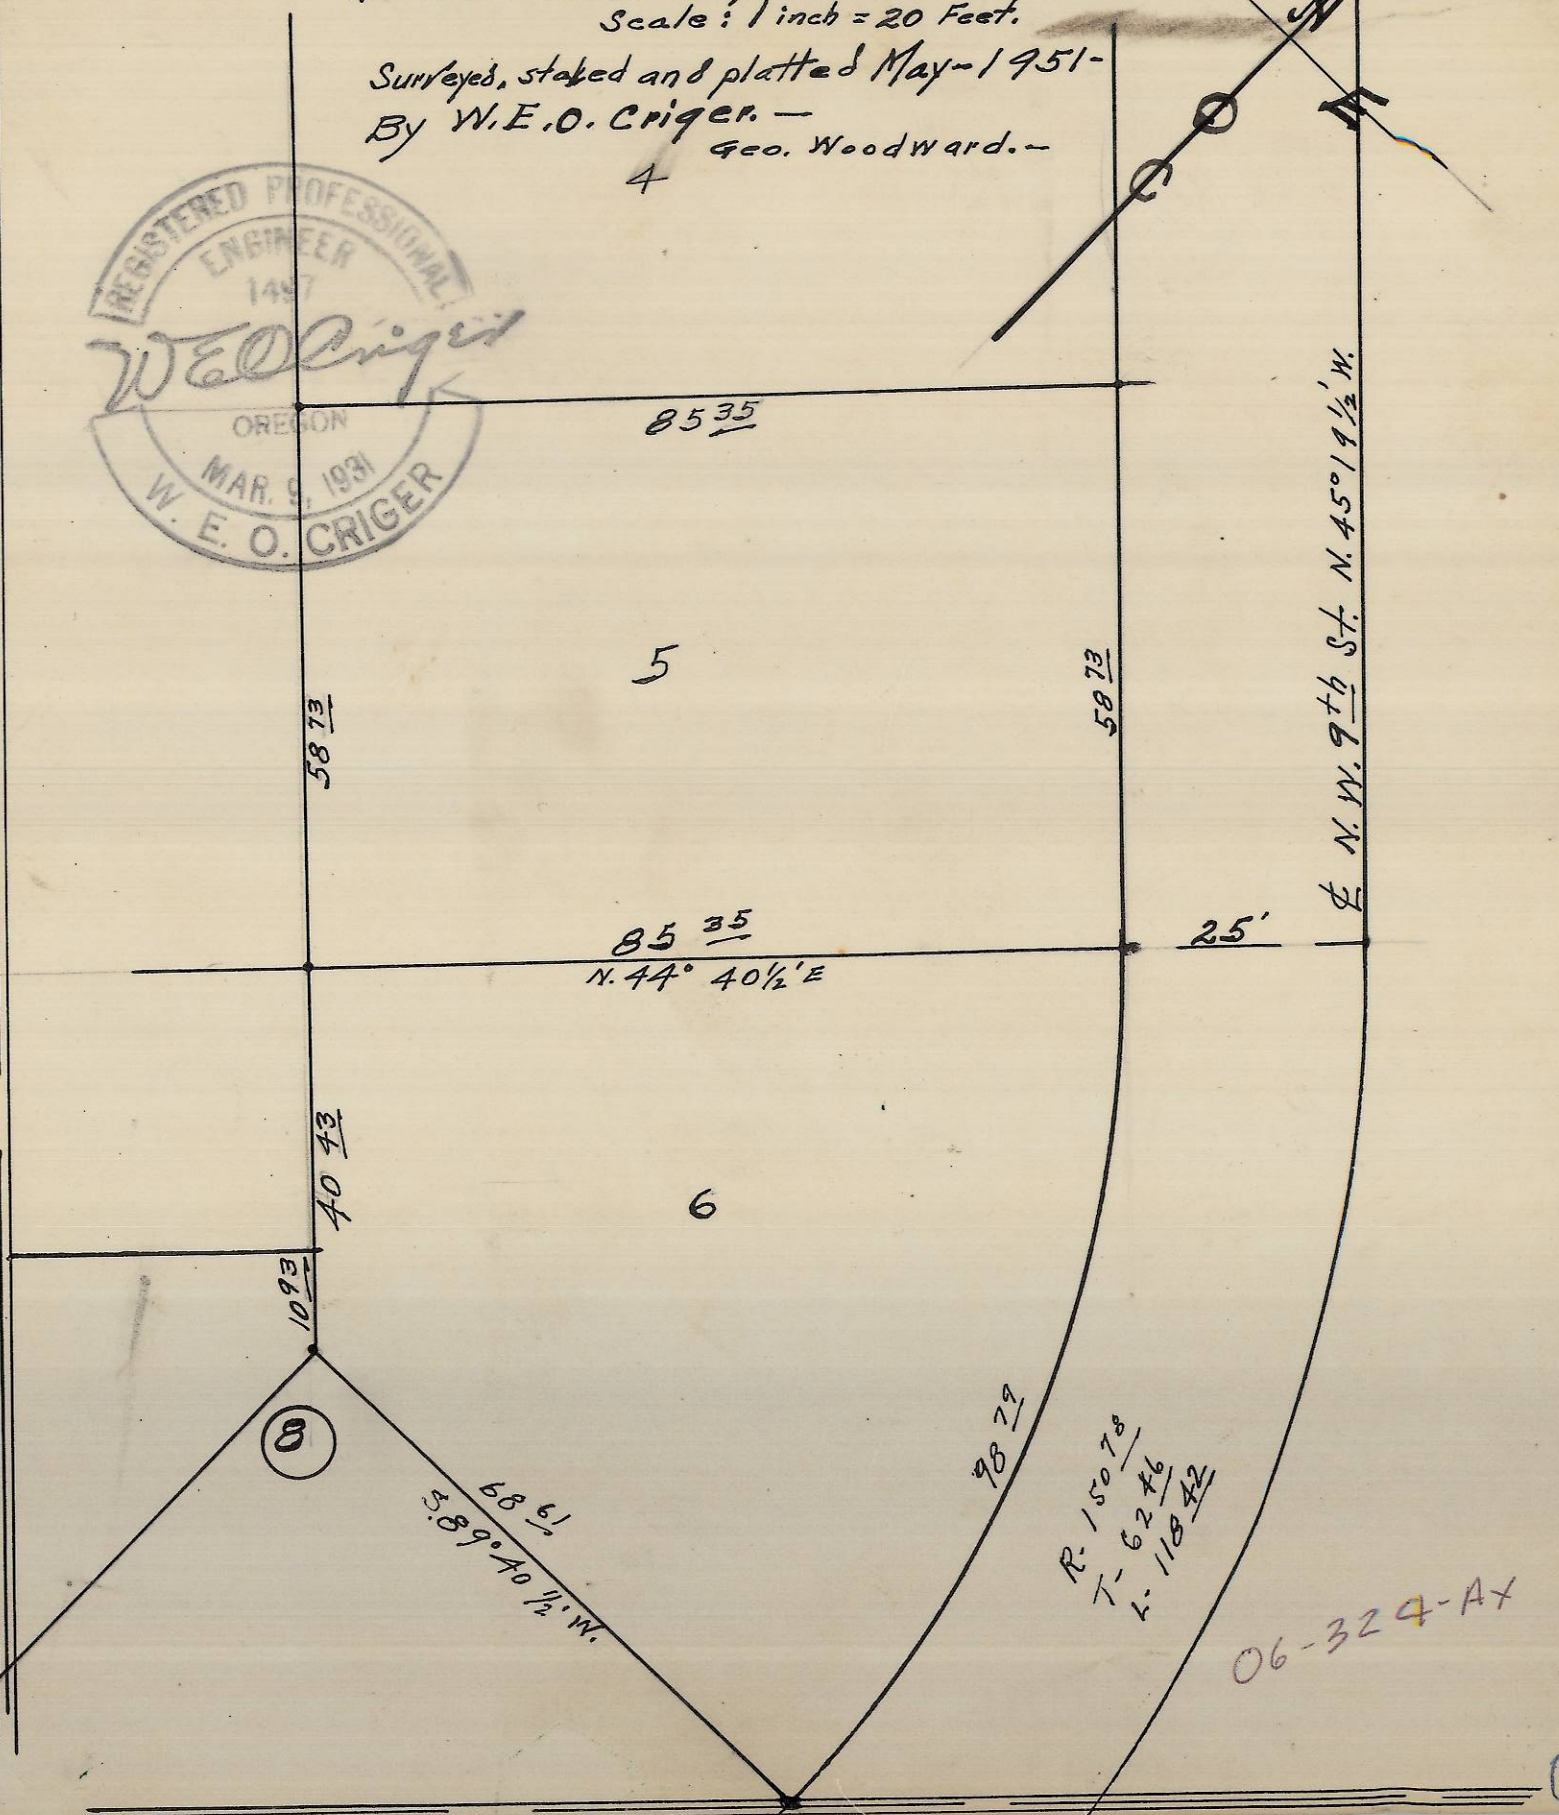

06-324-Ax