
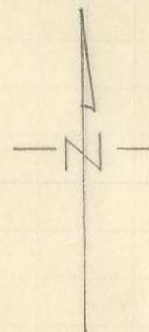


Block-101

EIGHTH STREET ---

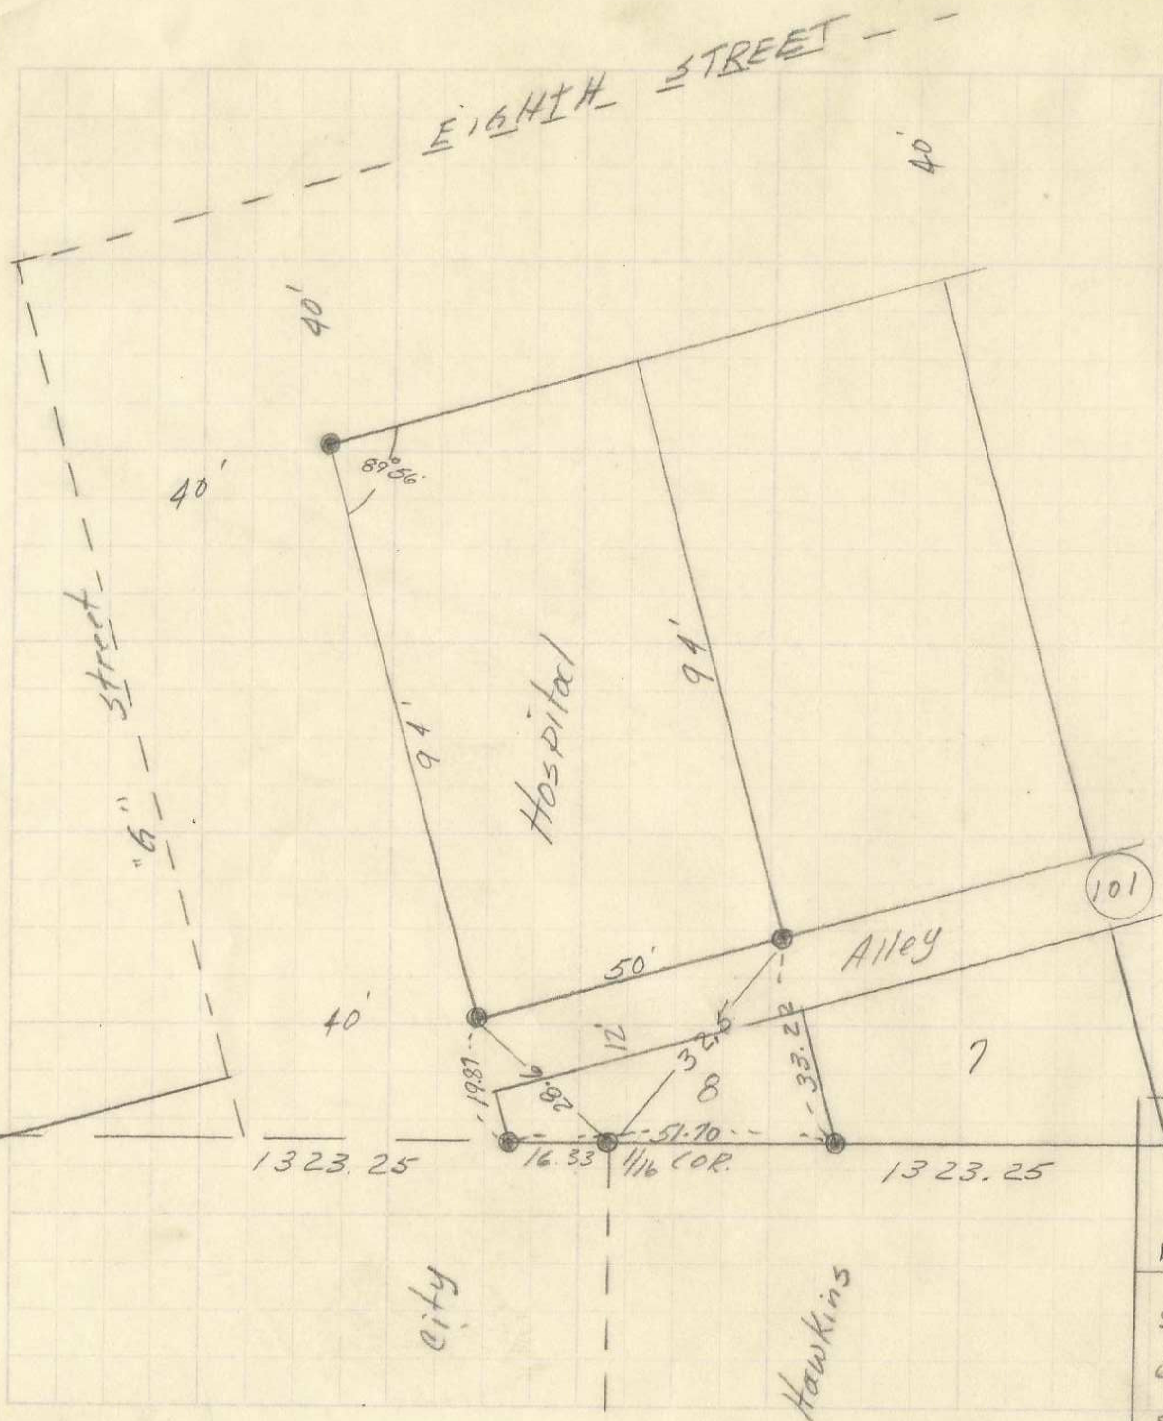

SCALE 1"=50

• IRON PINS

5N 28' 178D

G. M. NEWBILL
LICENSED LAND SURVEYOR

17N. Second Walla Walla, Wash. Phone 4170

Surveys	A SURVEY
Descriptions	FOR
Sub Divisions	UMATILLA HOSPITAL
	BLK 101 WARDWELL'S

Date	4/22/54	No	1571
Drawn by	G.M.N.		

06-390-AX