



LEGEND

- Placed 1/2" X 24" Iron Pins
- Found Original Iron Pins

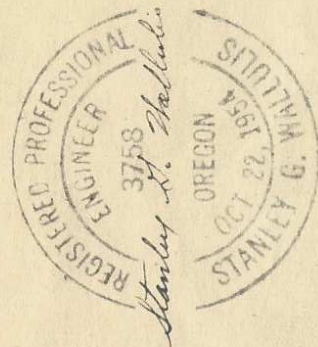

SCALE: 1" = 100'  
 DATE: 5-14-56  
 GAE

WALL AND TENNESON  
 Engineers  
 The Dalles  
 Oregon

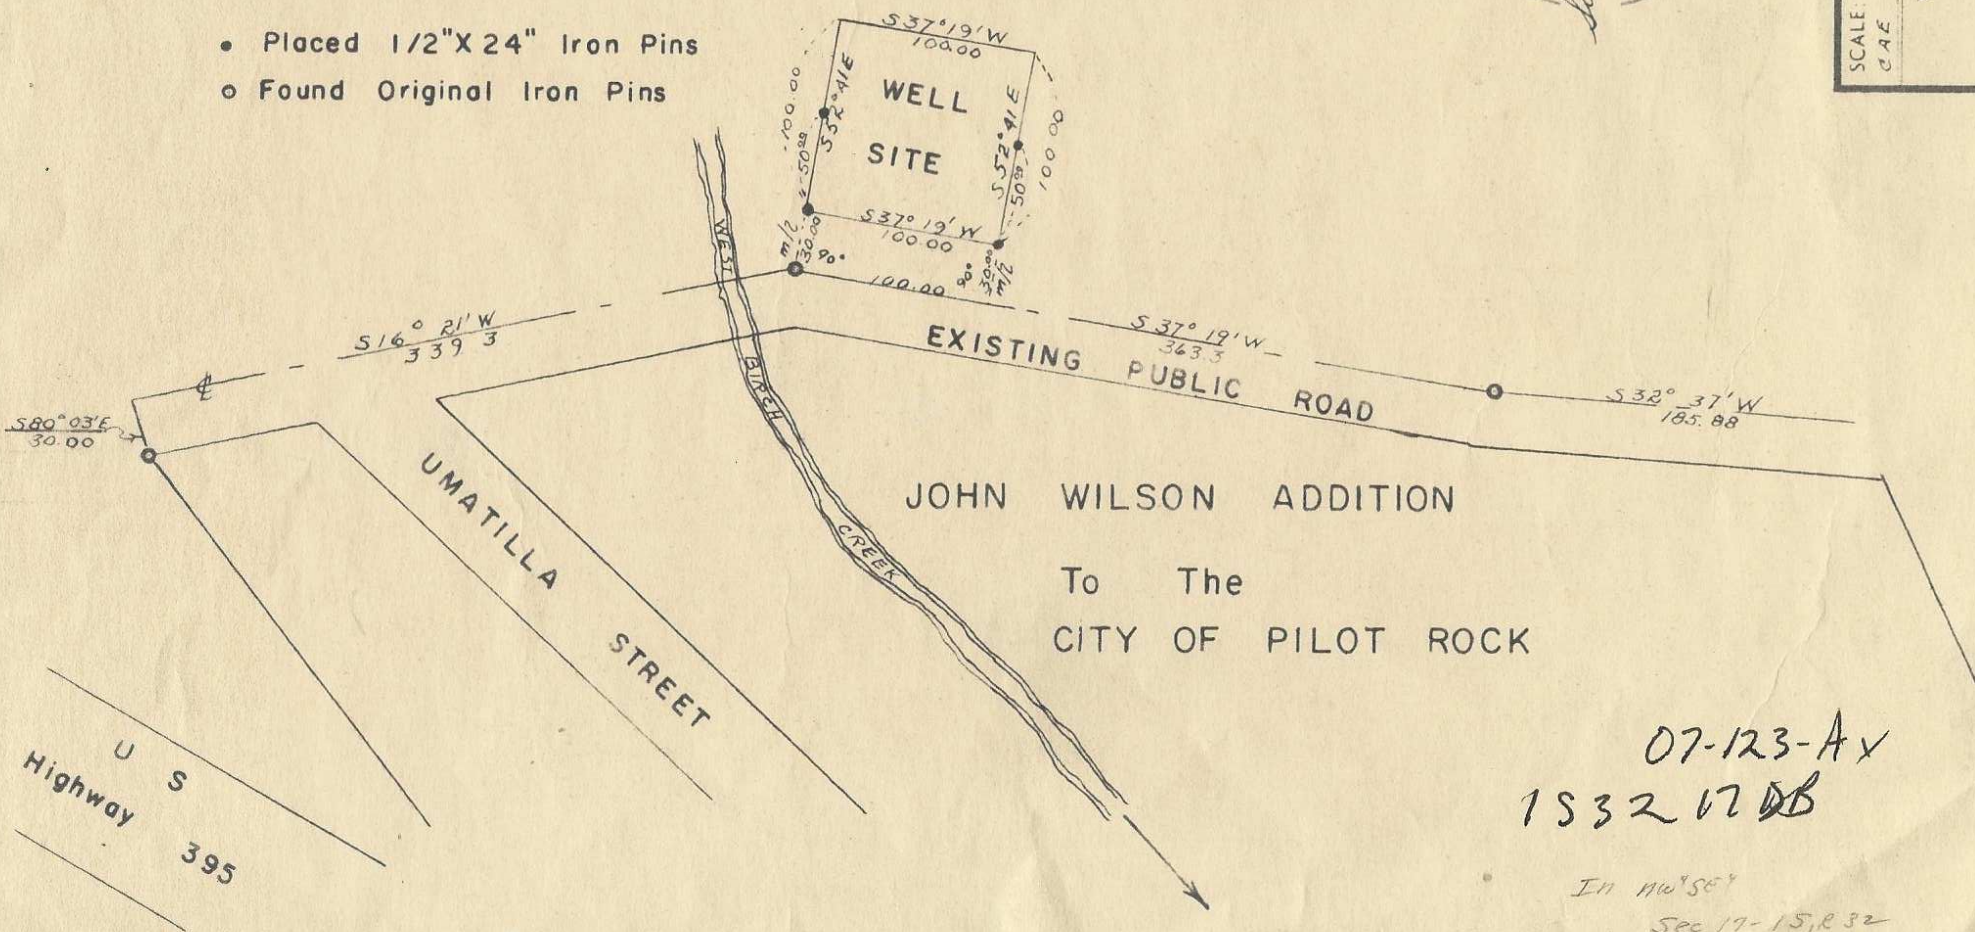

07-123-Ax  
 1532 17 DB

In NW 1/4 Sec 19-15, R 32